

Name Clifford Brooks

Service No.

101

3353

Address 140 Reed street

Location 140 Reed Street

Kind of Pipe

Size

Size of Main

~~REPAIRS~~—New Service

Com 12-1-47

Location

| Date | Material | Amount | Total | Date | Amount |
|--------------|--------------------------------|--------|-------|-------------------------------|--------|
| Sept. 3, '47 | Labor | 1 10 | 1 10 | Sept 2 '47 | 20 00 |
| | 10% Overhead | | 11 | Dec 4 '47 | 1 1/2 |
| | 40' - 3/4" Copper Tubing @.26 | 10 40 | 10 40 | | 15 51 |
| | 1 - 3/4" C x 1/2" I.W.H. S & W | 3 15 | 3 15 | Sept. 3, '47 | Labor |
| | Trucking 1 hr. @.75 | | 75 | | 9 50 |
| | | | 15 51 | 9' - 3/4" Copper Tubing @.26 | 2 34 |
| | | | | 1 - 3/4" C Corp-cock | 3 00 |
| | | | | 1 - 3/4" C x 3/4" C Curb-cock | 3 68 |
| | | | | 1 - Box & Rod | 4 26 |
| | | | | 1 - 1/2" Straight Tail Piece | 30 |
| | | | | 1 - 1/2" Offset Tail Piece | 30 |
| | | | | Trucking 1 hr. @.75 | 75 |
| | | | | | 24 13 |
| | Labor | | | | |

DATE _____

TOWN OF LEXINGTON - BOARD OF PUBLIC WORKS

WATER DIVISION

The undersigned applies for a supply of water at No..... St. and hereby agrees to comply with the rules and regulations as now, or at any future time, established by the Board of Selectmen.

Am't of Estimate \$.....

Owner


Am't Paid \$.....

Address

Builder

71 Reed St Lexington

Sketch of Service Here

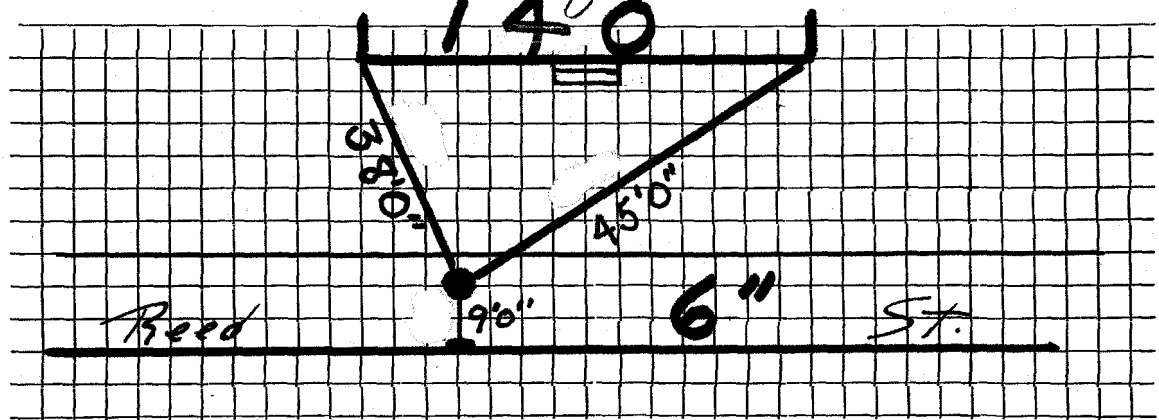

Connection made in Street.

Work completed19

Remarks: