

## WATER SERVICE RECORD

#177

Name Smith Builders

Service No. 18

Address 144 Reed St.

Lot 1

Location

~~Renewed Service~~ New Service W.O. #6305 R. Kirkland #1378


JUL 7 1969

Date	Material	Amount	Total	Date	Amount
5/20/69	Labor	10 46		5-13-69	125 00
	10% O.H.	1 04	11 50	7-7-69	53 67
35'	3/4" Copperpipe .79		27 65		71 33
1	3/4" Curb Cock		11 32		
1	3/4" Corporation		2 76		
1	Box & Rod		5 10		
2	Hrs. Shovel 6.50		13 00		
			71 33		
6-10-69	29' 3/4" Copper tubing				

DATE \_\_\_\_\_

# TOWN OF LEXINGTON -- BOARD OF PUBLIC WORKS

## WATER DIVISION

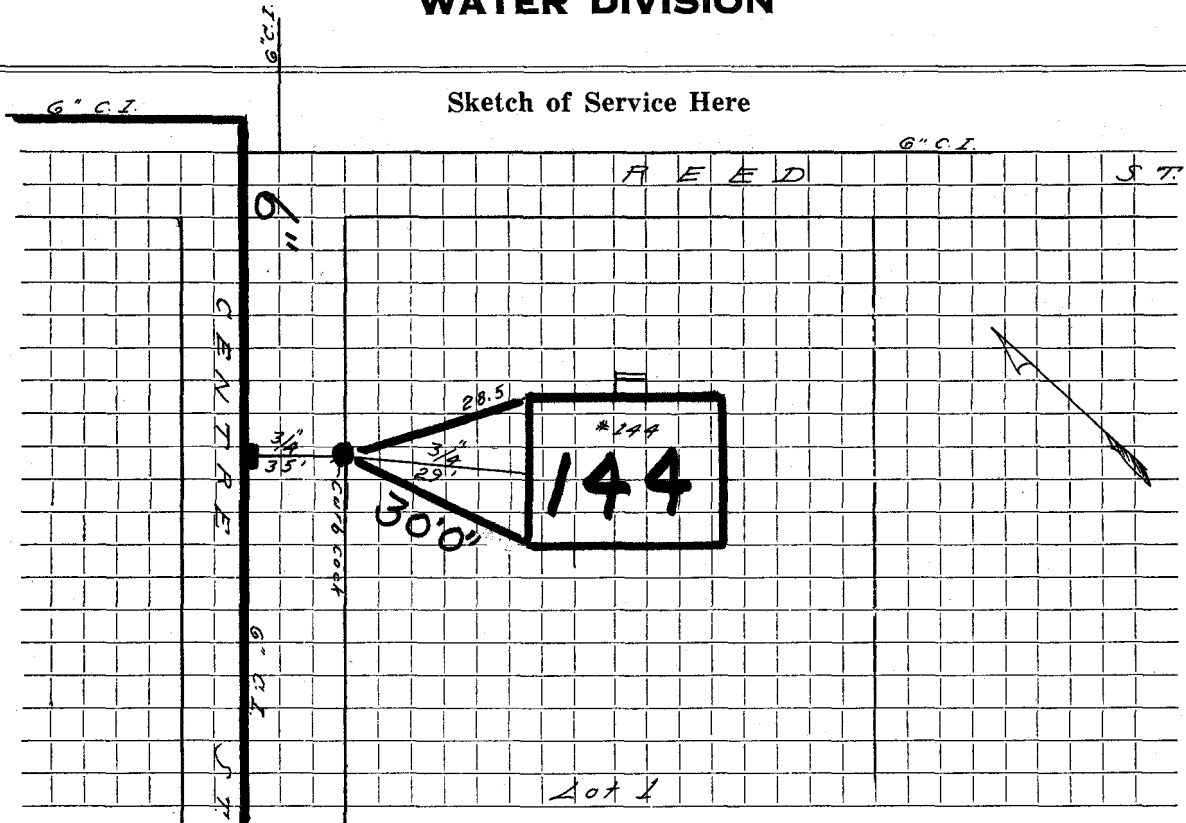

Connection made in ..... Street. Work completed .....

Remarks: .....

.....

.....