

WATER SERVICE RECORD

Name

Service No.

Address 153 Reed Street

Location

Repair—Renewal—New Service
 XXXXXX XXXXXXXXXXXX W.O. #311 & 306

Date		Material	Amount	Total	Date	Material	Amount
11/30/82	3'	x 3/4" Copper					
	1	1" x 4" C.L. Nipple					
	1	1" x 3/4" Copper to Iron Cplg.					
	1	1" Style 38					
	4	Ton Gravel					
					11/30/82	26'	3/4" Copper tubing
						1	3/4" x 5/8" lead to copper
						8	Ton gravel


OUTSIDE

DATE _____

TOWN OF LEXINGTON — BOARD OF PUBLIC WORKS

WATER DIVISION

Sketch of Service Here

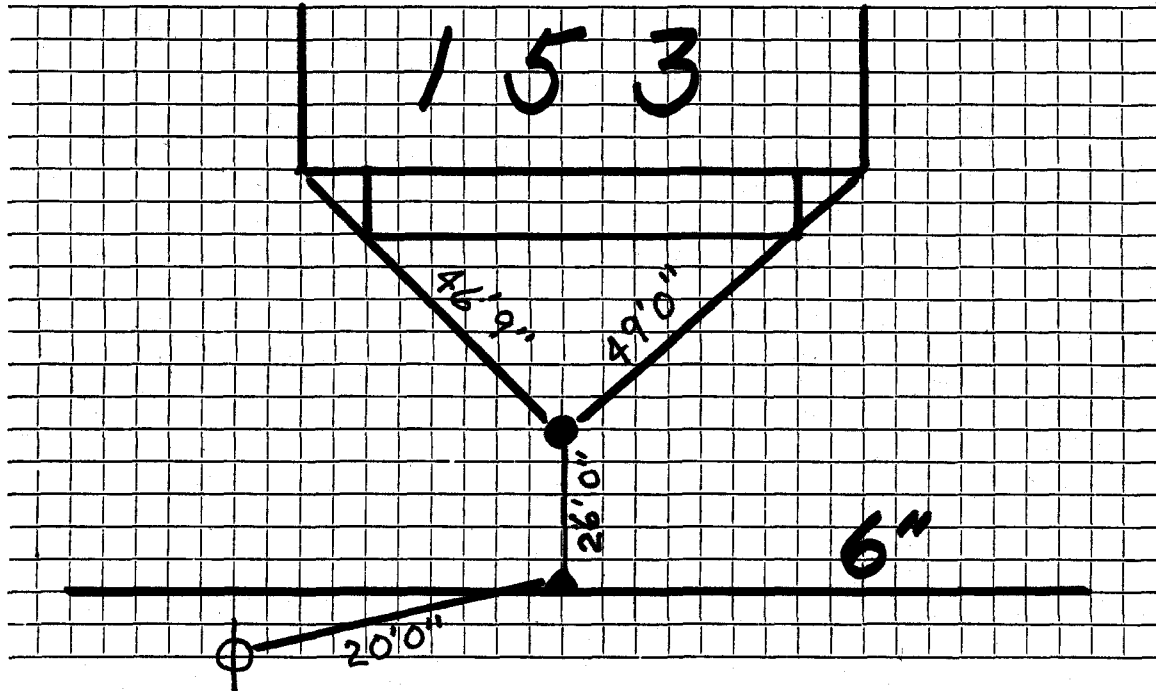

Connection made in Street. Work completed

Remarks:
.....
.....