

986

WATER SERVICE RECORD

Name Robert Shannon

Service No. 44

Address 155 Reed Street

Location

~~Renewed Account~~—New Service

W.O. # 8346

Bangano # 1988

APR 26 1972


Date	Material	Amount	Total	Date	Amount
12/16/71	Labor	15 42		12-14-72	150 00
	10% O.H.	1 54	16 96	4-30-72	75 45
40'	3/4" Copper pipe	.79	31 60		74 55
	3/4" Corporation		9 57		
	Box & Rod		5 10		
			74 55		
1-31-72	36' 3/4" Copper tubing				

DATE _____

TOWN OF LEXINGTON -- BOARD OF PUBLIC WORKS

WATER DIVISION

Sketch of Service Here

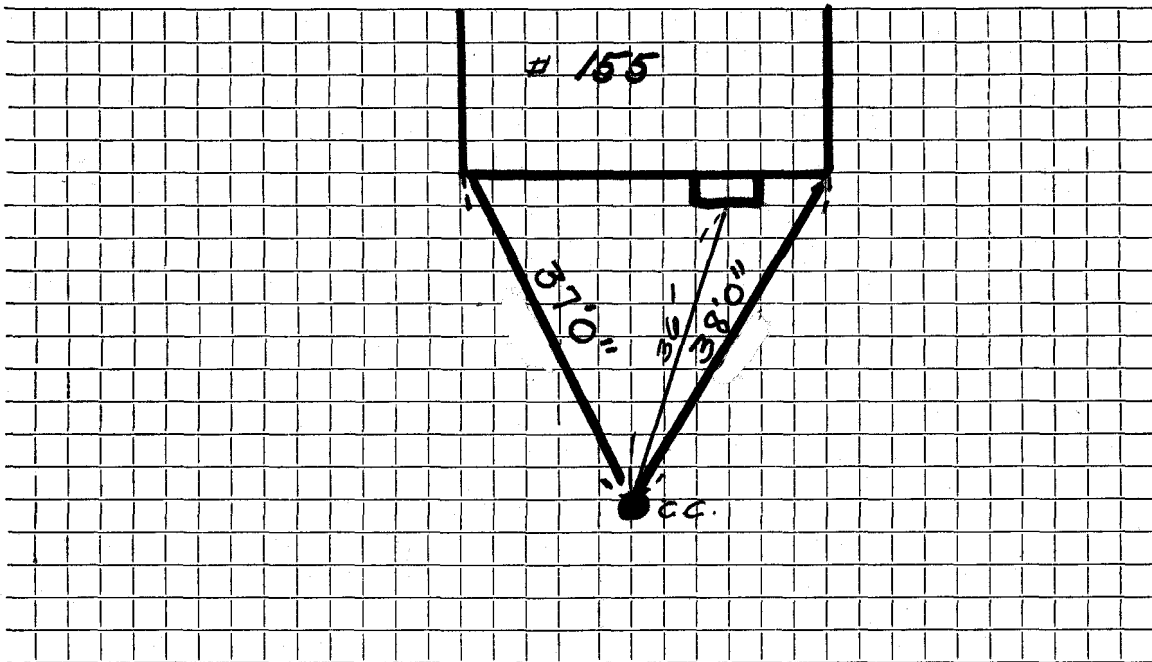

Connection made in Street. Work completed

Remarks:
.....
.....