

WATER SERVICE RECORD

Name Onel DeFlice, Jr.

Service No. 136

Address 156 Reed Street

Location

~~WORK ORDER~~ - New Service

Amount 8-22-65


Date	Material	Amount	Total	Date	Amount
7-27-60	Labor	1 94		7-19-60	50 00
	10% O.H.	<u>19</u>	2 13	8-22-65	<u>15 74</u>
	60' 1" Copper tubing @42		25 20		34 29
	1 1" Cx3/4" I.W.H. Stop&Waste		<u>6 96</u>		
			34 29		NON CHARGE
				Labor	1 53
				9' 1" Copper tubing @42	3 78
				1 1" C Corp Cock	4 91
				1 1" C Curb Cock	6 28
				1 Box & Rod	4 90
				1 3/4 Offset tailpiece	50
				1 3/4 Straight tailpiece	<u>50</u>
					22 40

DATE _____

TOWN OF LEXINGTON — BOARD OF PUBLIC WORKS

WATER DIVISION

Sketch of Service Here

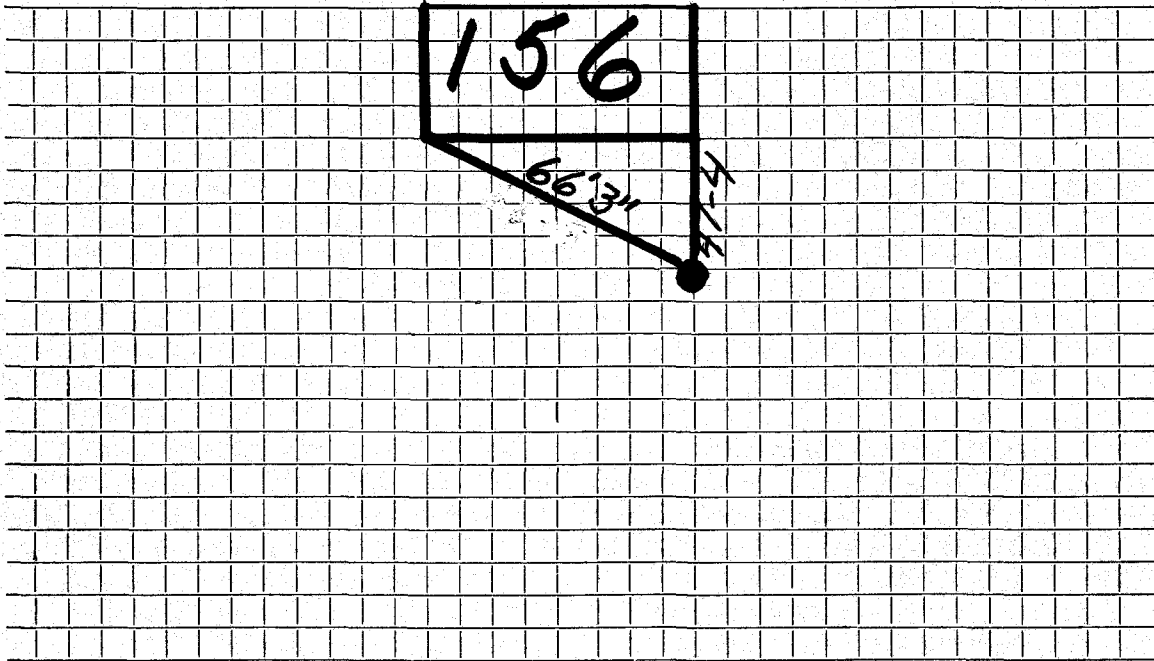

Connection made in Street. Work completed

Remarks:
.....
.....