

WATER SERVICE RECORD

Name

Service No.

Address

Location 159 REED ST

Repair ~~Renewal~~ ~~New Service~~ B-MCKEE

L.W.D.


Date		Material	Amount	Total	Date	Amount
5/97	15'	3/4 COPPER 3/4 VALVE			5/22/97	
					1	3/4x5/8 L.L. ADPT.
					10'	3/4 COPPER 3/4 COMP. CURB Box + Red
EXIST SERVICE		INST. 6-6-27				

DATE _____

TOWN OF LEXINGTON — BOARD OF PUBLIC WORKS

WATER DIVISION

Sketch of Service Here

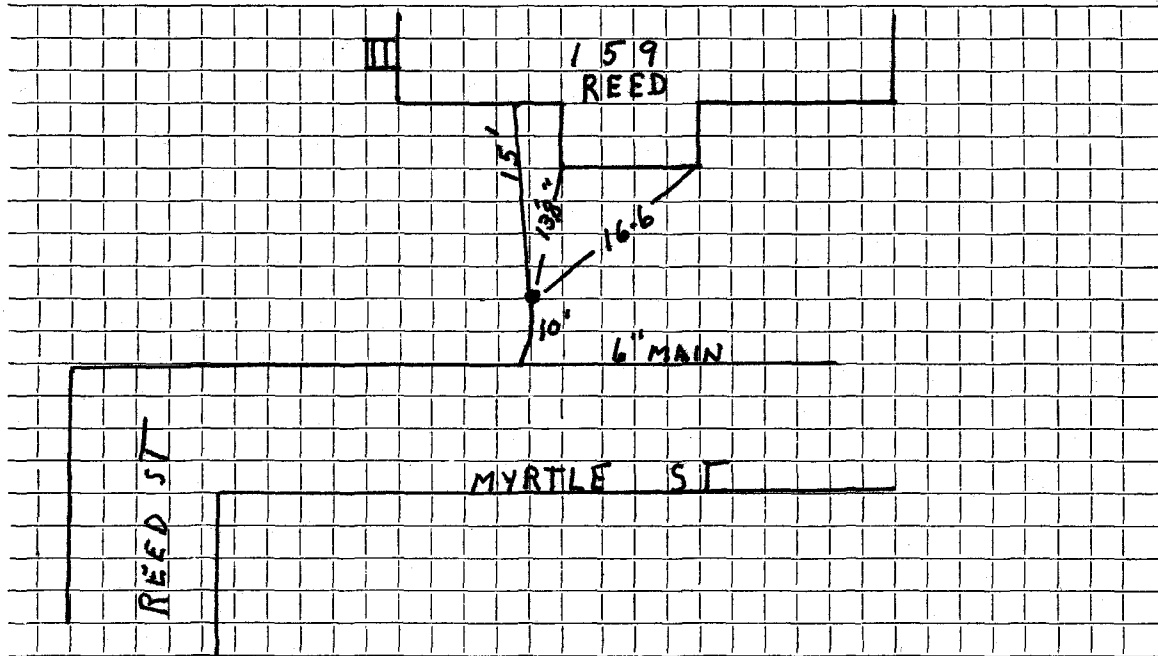

Connection made in Street. Work completed

Remarks:
.....
.....