

Name Daniel J. Omobono

3443

Service No. 307

Address 16 Reed Street

Lexington, Mass.

Locatio 16 Reed Street

Kind of Pipe

Size

Size of Main

~~Repair-Renewal~~—New Service

Com. 11-6-50

Location

Date	Material	Amount	Total	Date	Amount
Oct. 12, '50	Labor	1 50	1 50	Oct 4' 50	20 00
	10% Overhead		15		
	37' - 3/4" Copper Tubing @.31		11 47		17 63
	1 - 3/4"C x 1/2" I.W.H. S&W		3 76	Oct. 12, '50	1 50
	Trucking 1 hr. @.75		75	14' - 3/4" Copper Tubing @.31	4 34
			17 63	1 - 3/4"C Corp-cock	3 60
				1 - 3/4"C x 3/4"C Curb-cock	4 40
				1 - Box & Rod	4 44
				1 - 1/8" Offset Tail Piece	42
				1 - 1/8" Straight Tail Piece	42
				Trucking 1 hr. @.75	75
					19 87
	Labor				

DATE _____

TOWN OF LEXINGTON—BOARD OF PUBLIC WORKS

WATER DIVISION

The undersigned applies for a supply of water at No. _____ St. and hereby agrees to comply with the rules and regulations as now, or at any future time, established by the Board of Selectmen.

Am't. of Estimate \$ _____


Owner _____

Am't. Paid \$ _____

Address _____

Builder _____

Sketch of Service Here

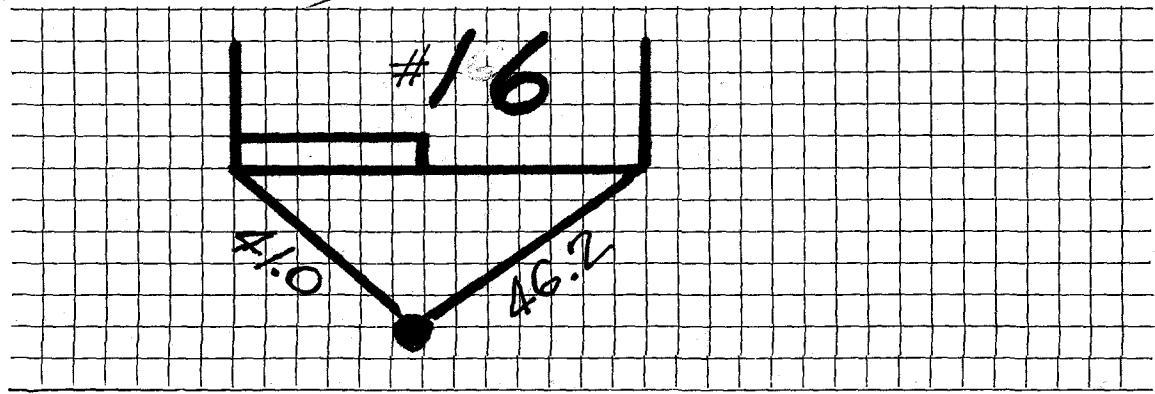

Connection made in _____ Street.

Work completed _____ 19

Remarks: