

## WATER SERVICE RECORD

Name Joseph Chisholm

Service No. 253

Address 160 Reed Street

Location


~~REPAIRS~~ - New Service

Comm 12-14-59

Date	Material	Amount	Total	Date	Amount	
10-14-59	Labor	1.85		11-6-59	Deposit	50.00
	10% O.H.	.19	2.04	12-14-59	Refund	16.13
60'	3/4" Copper tubing@.42		25.20			33.87
1	3/4" Cx $\frac{1}{2}$ I.W.H. Stop&Waste		5.88			
1	Hr. Trucking@.75		.75		NON CHARGE	
			33.87		Labor	1.61
6-9-57	1 3/4 Flange Unions			12'	3/4" Copper tubing@.42	5.04
	3' 3/4 Copper			1	3/4" C Corp Cock	4.67
				1	3/4" C Curb Cock	5.98
				1	Box & Rod	4.90
				1	$\frac{1}{2}$ Straight tailpiece	.50
				1	$\frac{1}{2}$ Offset tailpiece	.50
						23.20

TOWN OF LEXINGTON — BOARD OF PUBLIC WORKS  
WATER DIVISION

Sketch of Service Here

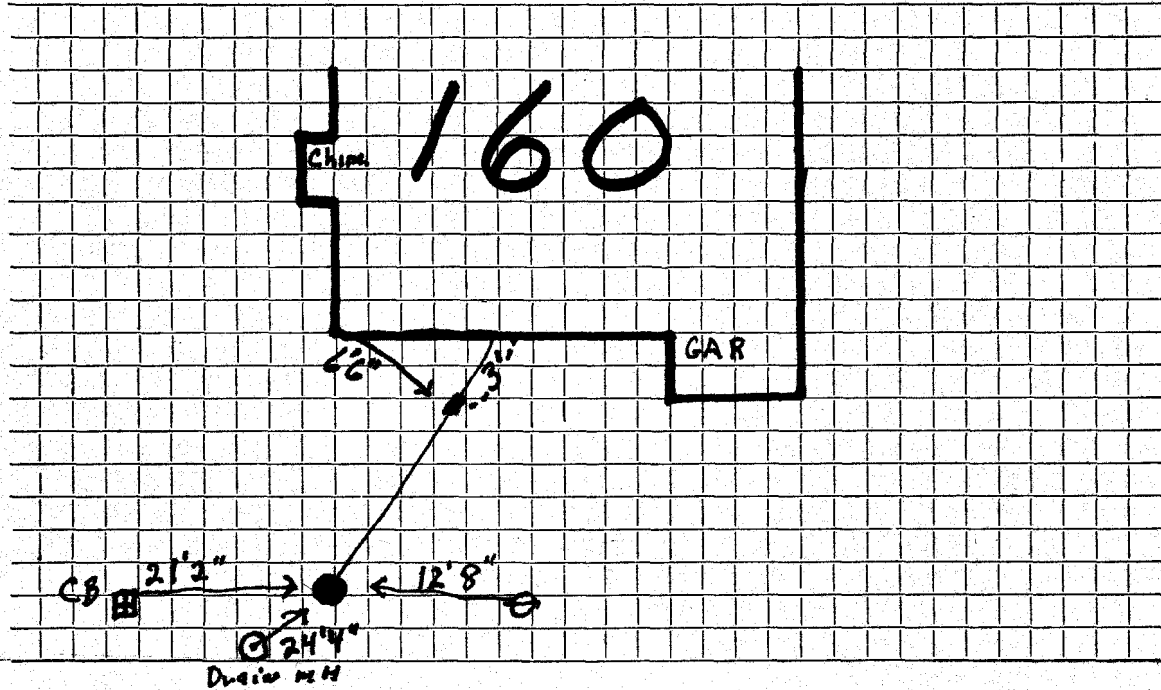

Connection made in ..... Street. Work completed .....

Remarks: .....  
.....  
.....