

Name

Service No. **2308**
2880

Address **23 Reed St.**

Location **23 Reed St.**

Kind of Pipe

Size

Size of Main

Repair—Renewal—New Service

Location

Date

Material

Amount

Total

Date

Amount

Labor

DATE _____

TOWN OF LEXINGTON—BOARD OF PUBLIC WORKS

WATER DIVISION

The undersigned applies for a supply of water at No. _____ St. and hereby agrees to comply with the rules and regulations as now, or at any future time, established by the Board of Selectmen.

Am't. of Estimate \$ _____

Owner

fr. Viano


Am't. Paid \$ _____

Address

23 ~~37~~ Reed St.

Builder _____

Sketch of Service Here

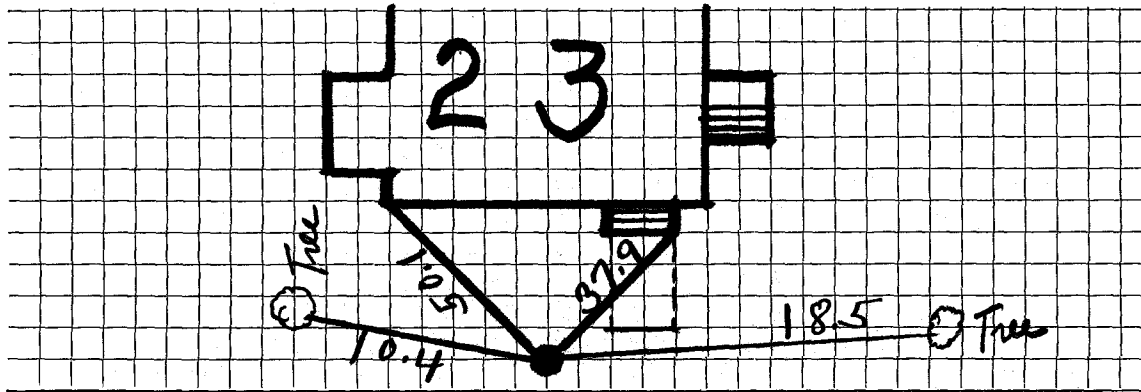

Connection made in Reed Street. St. Work completed _____ 19

Remarks: