


DATE 6-4-93

TOWN OF LEXINGTON — BOARD OF PUBLIC WORKS

WATER DIVISION

Sketch of Service Here

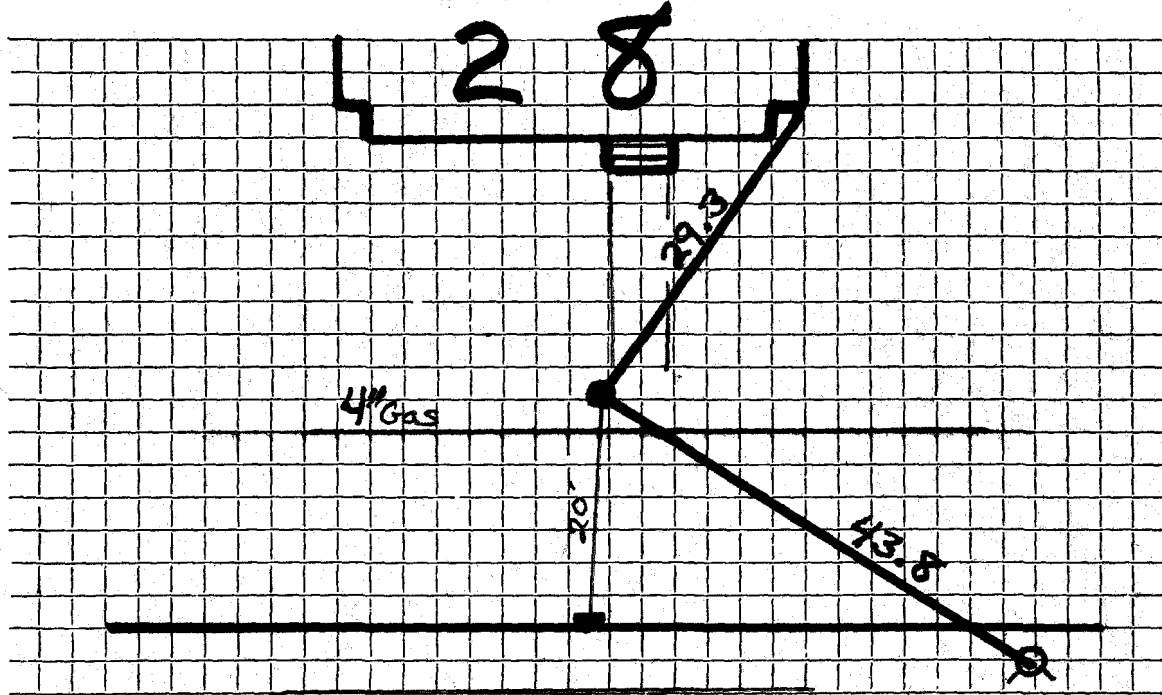

Connection made in Street. Work completed 6-2-93

Remarks: Curb 3 1/2' From 4" Gas

3/4 Curb buried 20' From New Curb

Original Service 10-11-50