

WATER SERVICE RECORD

Name **Raymond Doucette**

Service No.

Address **33 Reed Street**

Location

Repair—~~Replaced New Sewing~~ **Dennis Doherty #3632**


Date		Material	Amount	Total	Date	Amount
12/27/80	96'	3/4" Copper tubing				
	1	3/4" 3 part Union				
12/28/80		Labor				
	2	3/4" Style 38			6/23/81	
	1	Box & Rod				
	1	1" x 3/4" Curb Cock			30'	3/4" Copper tubing
	1	3/4 x 1" Cply			1	3/4" Corp.
	1	3/4 x 5 Cement L. Nipple			1	3/4" Curb
	1	hr. Trucking			1	ton Cold Patch
	1	hr. Town Shovel				26' x 10' Patch
	1	hr. Compressor			4 1/2	Trucking
					3	hrs. Town Shovel
					1	hr. Roller

DATE _____

TOWN OF LEXINGTON — BOARD OF PUBLIC WORKS

WATER DIVISION

Sketch of Service Here

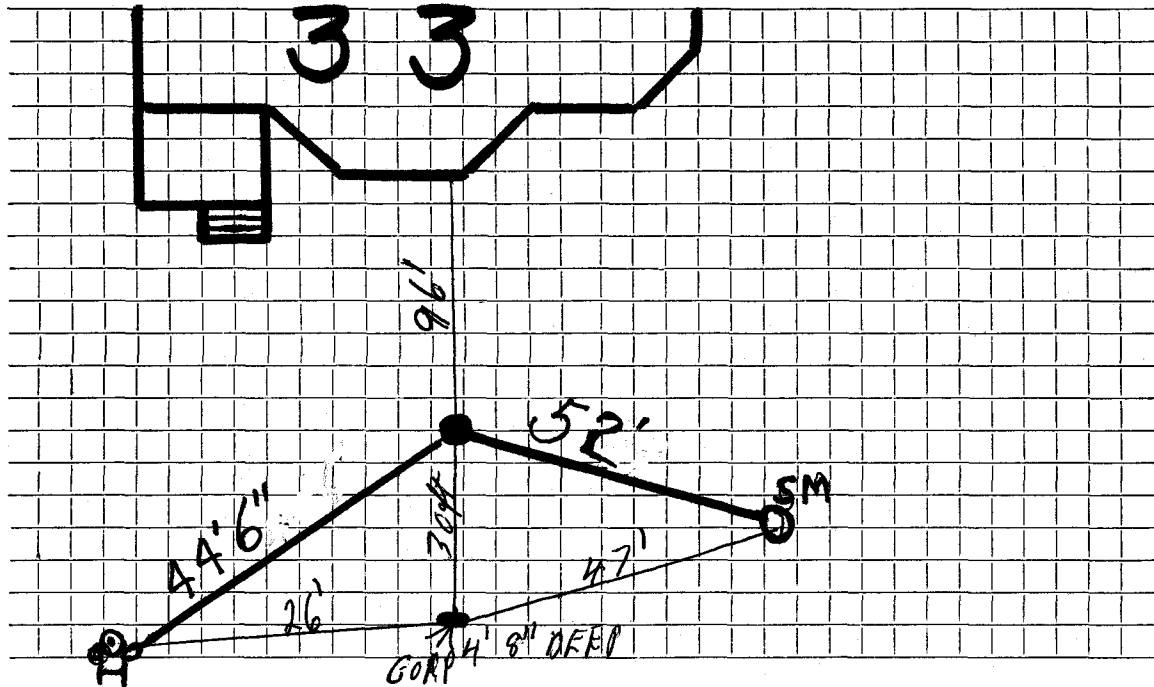

Connection made in Street. Work completed

Remarks:
.....
.....