

## WATER SERVICE RECORD

Name N.Y. Bros Trust

Service No. 32

Address 35 Reed St

Location

Repair—Renewal—New Service

Valeri #3116 W.O. #1157

FEB 10 1975

Date		Material	Amount	Total	Date	Amount
50/12/73	57'	3/4" Copper tubing			8-8-73	Deposit 100 00
8/20/73		Labor	30.26		5-10-75	* Returned 8 85
		10% O.H.	3.03	33.29		91 12
	31'	3/4" Copper tubing @.60		18.60		
	1	3/4" Corp Cock		9.57		
	1	3/4" Curb Cock		11.32		
	1	Box & Rod		7.34		
	1/4	ton Patch		1.50		
	1	hr. Trucking		3.00		
	1	hr. Town Shovel		6.50		
				91.12		


\* Apply to SHC #83

DATE \_\_\_\_\_

TOWN OF LEXINGTON — BOARD OF PUBLIC WORKS

WATER DIVISION

Sketch of Service Here

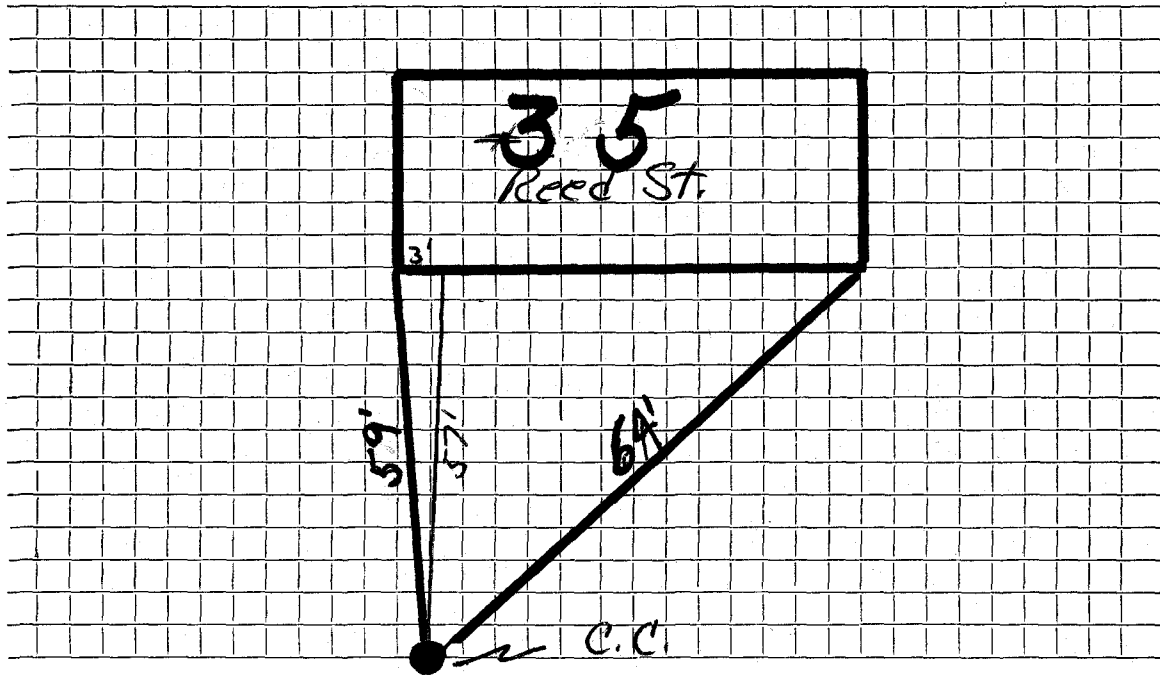

Connection made in ..... Street. Work completed .....

Remarks: .....

.....  
.....