

Name

Service No. 2312

Address

36 Reed St.

#4067

Location

36 Reed St.

Kind of Pipe

Size

Size of Main

Repair—Renewal—New Service

Location

Date

Material

Amount

Total

Date

Amount

4-10-92 Check ~~XXXXXXXXXX~~
1" IRON

10-24-03 GAS CO hit
SERVICE lead
REPLACED with
10' - 1" Copper
COOP adaptor
1" - Curb
6" - 3/4 union

Labor

DATE _____

TOWN OF LEXINGTON—BOARD OF PUBLIC WORKS

WATER DIVISION

The undersigned applies for a supply of water at No. _____ St. and hereby agrees to comply with the rules and regulations as now, or at any future time, established by the Board of Selectmen.

Am't. of Estimate \$ _____


Owner Wayer.

Am't. Paid \$ _____

Address 36~~th~~ Reed St

Builder _____

Sketch of Service Here

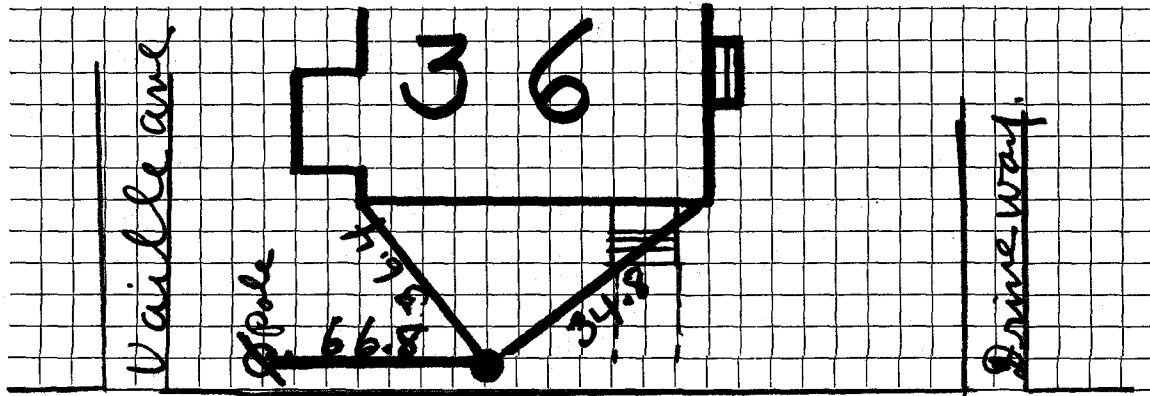

Connection made in Reed Street. St Work completed _____ 19

Remarks: