

Name W. B. C. Meady

Service No. ~~50~~ 2314

#3755

Address 124 Bedford St., Lexington

#7268

39 Reed St.

Location Lot #2, Reed St. #39

Kind of Pipe

Size

Size of Main

~~Repair-Renewal~~ New Service

Location

Date	Material	Amount	Total	Date	Amount
P. 5-22-24 for 15.00	33' 1" C.L. Pipe @ .27	8 91		April 18 1925 - Cash	15.00
	2 1" L.L. Coup. @ .25	50			
	1 1" L.L. Elbow	30			
	1 1" Br. Sp. Nipple	25			
	1 S & W	3 00			
	Trucking	75	13 71		
5/4/28	2 Hrs. Labor @ .65	1 30			
	15% Overhead	20	1 50		
			15 21	Pay \$15.00 ✓	

Labor

Hadley Press, Inc. Lexington

DATE 4/18/28

TOWN OF LEXINGTON—BOARD OF PUBLIC WORKS

WATER DIVISION

The undersigned applies for a supply of water at No. Reed Lot #2 St. and hereby agrees to comply with the rules and regulations as now, or at any future time, established by the Board of Selectmen.

Am't. of Estimate \$ 20⁰⁰

Owner W. By C. Meady.


Am't. Paid \$ 15⁰⁰

Address Lot #2

Builder Schawms.

Reed W. Knight.

Sketch of Service Here

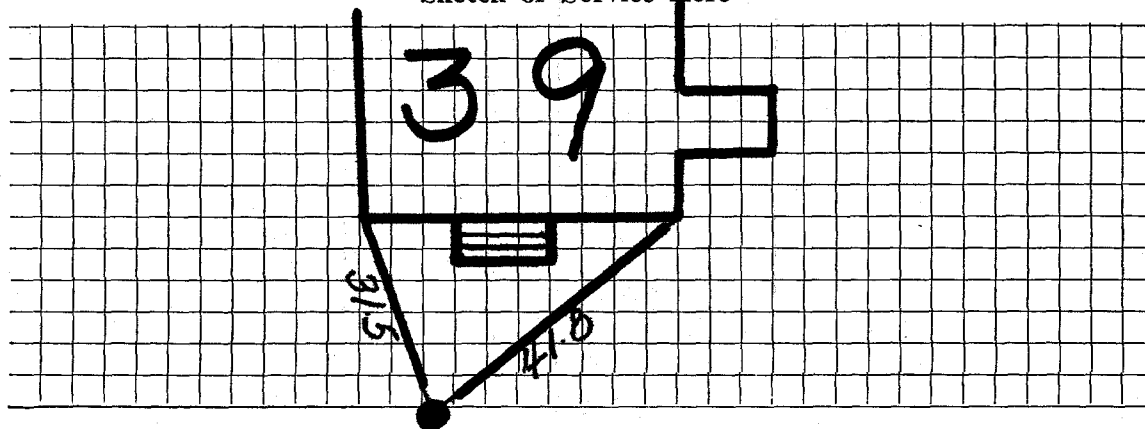

Connection made in _____ Street.

Work completed _____ 19

Remarks: