


TOWN OF LEXINGTON — BOARD OF PUBLIC WORKS

WATER DIVISION

Sketch of Service Here

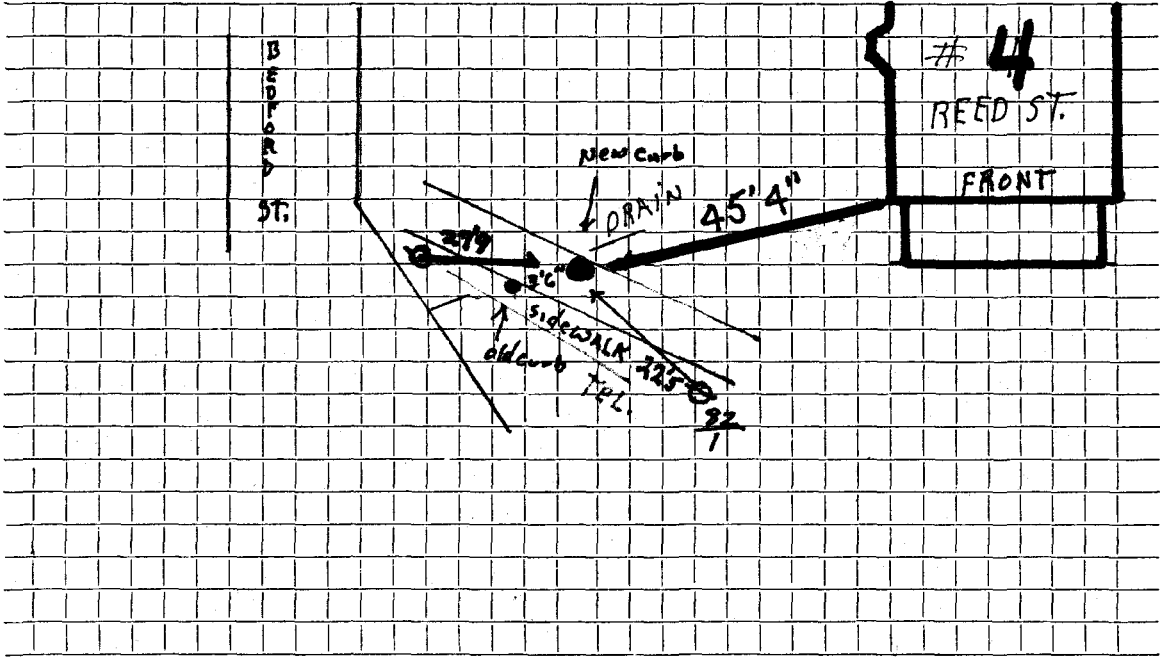

Connection made in *Services goes over drain 3 1/2 to old* Street. Work completed

Remarks: *18" Drain - GAS & TEL*