

Name

K. Grinnell

Service No. 39

2700

Address

40 Reed Street

Lexington, Mass.

Location

40 Reed Street

Kind of Pipe

Size

Size of Main

xRepair—Renewal—New Service

Con. 4-17-50

Location

Date	Material	Amount	Total	Date	Amount
Mar. 20 '50	Labor	1 35			
	10% Overhead	14	1 49		
	34'- 3/4" Copper Tubing @ 23¢		7 82		
	1- 3/4"C x 1/2" I.W.H. S & W		3 29		
	1 hr. Trucking		75		
			13 35		
				Mar. 20 '50	
					4 05
					2 30
					3 15
					3 85
					38
					75
					14 48
	Labor				

Bill sent 4-21-50

May 6 '50

no deposit
6 and

13 35

Non-Charge

10'- 3/4" Copper @
Tubing 23¢

1- 3/4"C. Corp-cock

1- 3/4"C x 3/4"C Curb-
cock

1- 1/2" Straight Tail Piece

1 hr. Trucking

DATE _____

TOWN OF LEXINGTON – BOARD OF PUBLIC WORKS
WATER DIVISION

The undersigned applies for a supply of water at No..... St. and hereby agrees to comply with the rules and regulations as now, or at any future time, established by the Board of Selectmen.

Am't of Estimate \$.....

Owner


Am't Paid \$.....

Address

Builder

.....

Sketch of Service Here

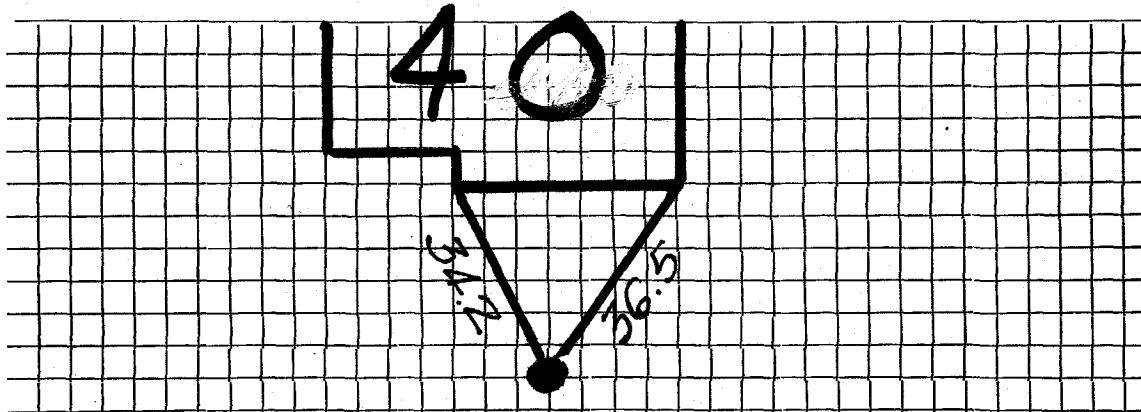

Connection made in Street.

Work completed19

Remarks: