

Name

Service No. 2317

Address

42 Reed St.

#6710

Location

42 Reed St.

Kind of Pipe

Size

Size of Main

Repair—Renewal—New Service

Location

Date

Material

Amount

Total

Date

Amount

Labor

Hadley Press, Inc., Lexington

DATE \_\_\_\_\_

# TOWN OF LEXINGTON—BOARD OF PUBLIC WORKS

## WATER DIVISION

The undersigned applies for a supply of water at No. \_\_\_\_\_ St. and hereby agrees to comply with the rules and regulations as now, or at any future time, established by the Board of Selectmen.

Am't. of Estimate \$ \_\_\_\_\_

Owner

Johnson.


Am't. Paid \$ \_\_\_\_\_

Address

42 #6 Reed St.

Builder \_\_\_\_\_

Sketch of Service Here

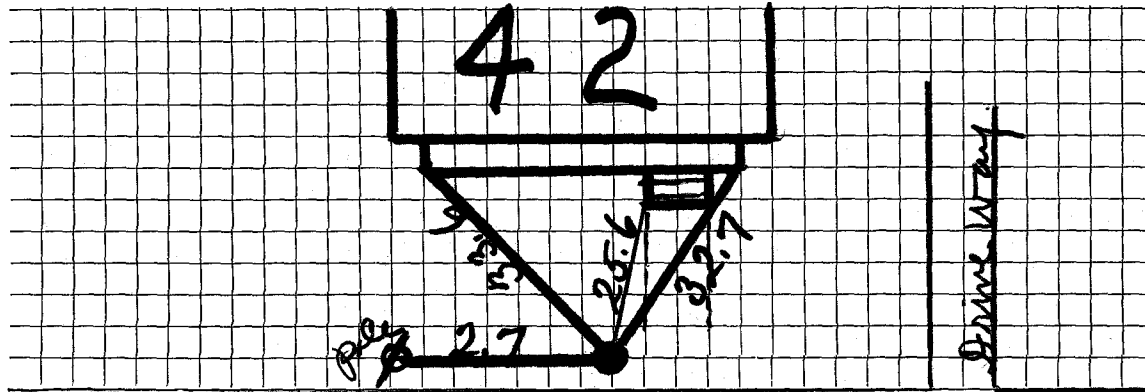

Connection made in Reed Street. St Work completed \_\_\_\_\_ 19

Remarks: