

WATER SERVICE RECORD

Name Clifford C Cooper

Service No. 57

#5571

#6025

Address 43 Reed Street

Location

~~Repair—Renewal—New Service~~

W. O. # 7097

APR 6 1970


| Date | Material | Amount | Total | Date | Amount |
|----------|--------------------------|--------|--------|----------|-------------------------------|
| 11/10/69 | Labor | | 39 60 | 11-10-69 | 150 00 |
| | 10% O.H. | | 3 96 | 2-4-70 | 49 95 |
| | 34' 3/4" Copperpipe .79 | | 26 86 | | 100 05 |
| | 3/4" X 1/2" Stop & Waste | | 11 13 | | |
| | 1 Hr. Trucking | | 3 00 | 11/10/69 | <u>OUTSIDE</u> Labor 37 60 |
| | 2 Hrs. shovel 6.50 | | 13 00 | 12/10/69 | " 26 19 |
| | 1/2 Hr. compressor 5.00 | | 2 50 | 26' | 3/4" Copperpipe .79 20 54 |
| | | | 100 05 | | 3/4" Curb Stop 8 37 |
| | | | | | 3/4" Corp. Adaptor 2 76 |
| | | | | 1 | Box & rod 5 10 |
| | | | | 1 | Ton hot top 5 85 |
| | | | | 1/2 | " cold patch 5.85 2 93 |
| | | | | 2 1/2 | Hrs. trucking 3.00 7 58 |
| | | | | 1 | Hr. shovel 4 00 |
| | | | | 1/2 | Hr. compressor 5.00 2 50 |
| | | | | 1/2 | Hr. roller 3.00 1 50 |
| | | | | | Trailer 2 00 |
| | | | | | <u>128 34</u> |

DATE _____

TOWN OF LEXINGTON -- BOARD OF PUBLIC WORKS

WATER DIVISION

Sketch of Service Here

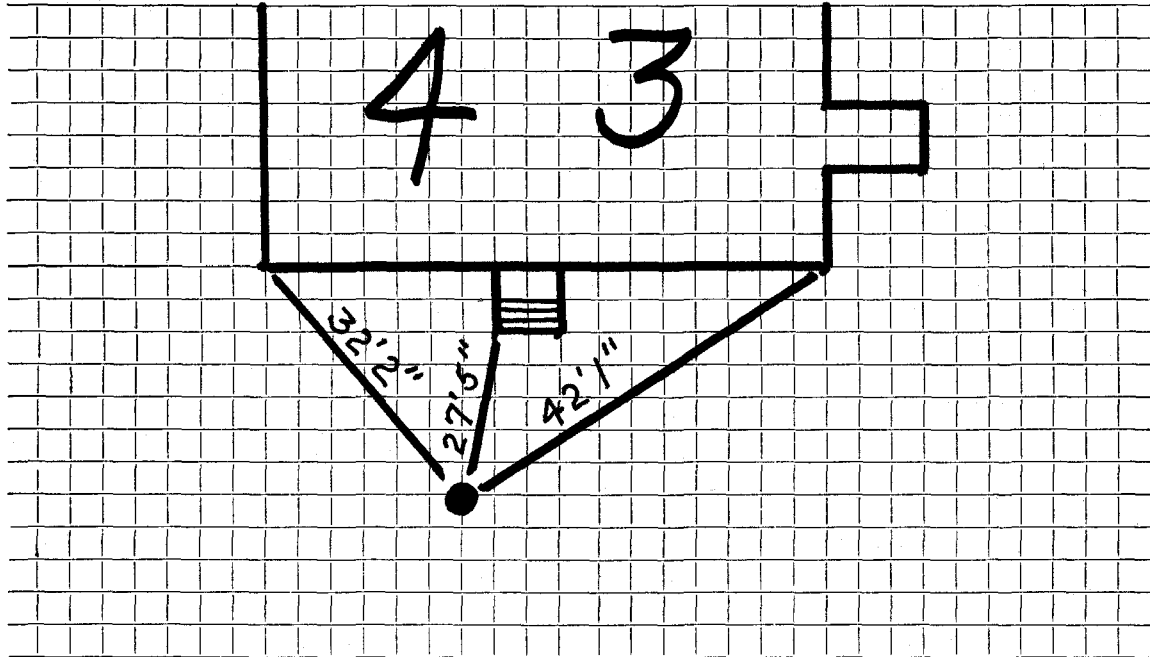

Connection made in Street. Work completed

Remarks: *Original Service 6-29-28*

.....
.....