

## WATER SERVICE RECORD

Name Frank Pivarunas

Service No. 90

Address 44 Reed Street

Location

~~Repair—Renewal—New Service~~

12-13-78 Killed Water Service

Comm 9-24-56

Date	Material	Amount	Total	Date	Amount
5/8/56	Labor	1 95		5-8-56	Deposit 30 00
	10% overhead	20	2 15	9-24-56	Paid \$ 2 11
	50' 3/4" copper tubing @ .4850		24 25		<u>NON CHARGES</u> 32 11
	1 3/4" C x 1/2" I.W.H. stop&waste		4 96	10' 3/4" copper tubing @ .4850	4 85
	1 hr. trucking @ .75		75	Labor	1 95
			32 11	1 3/4" C Corp Cock	4 34
				1 3/4" C Curb Cock	5 94
				1 Box & Rod	4 62
				1 1/2 Straight Tail Piece	50
				1 1/2 Offset Tail Piece	50
					<u>22 70</u>


\* Paid by refund on S.H.C. #45

DATE \_\_\_\_\_

TOWN OF LEXINGTON — BOARD OF PUBLIC WORKS

WATER DIVISION

Sketch of Service Here

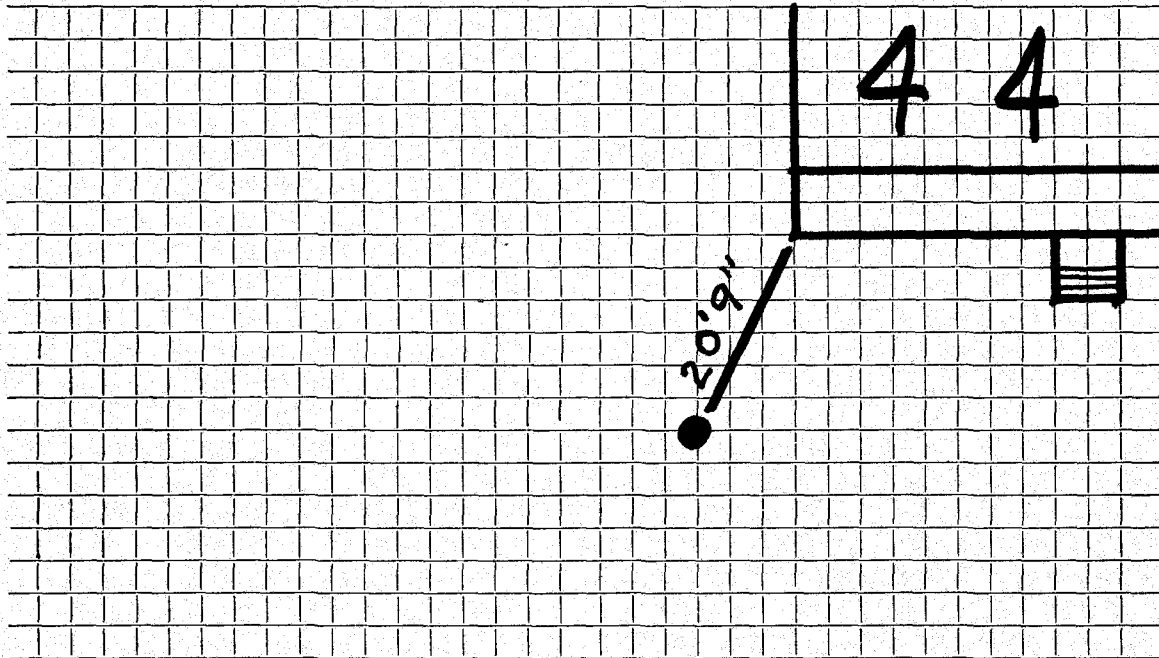

Connection made in ..... Street. Work completed .....

Remarks: *OWNER SAID IT IS IRON SERVICE 4-10-92* .....

.....  
.....