

Name Gertrude Sandison

Service No. 269

Address 46 Reed Street

Lexington, Mass.

Location 46 Reed Street

Kind of Pipe

Size

Size of Main

~~Repair—Renewal—New Service~~

Com. 9-5-50

Location

Date	Material	Amount	Total	Date	Amount
Jul. 28, '50	Labor	1 30	1 30	Sept 28 '50	15 57
	10% Overhead		13		
	44' - 3/4" Copper Tubing @.23		10 12		No Charge
	1 - 3/4"C x 1/2" I W H S&W		3 29	Jul. 28, '50	1 30
	Trucking 1 hr. @.75		75	11' - 3/4" Copper Tubing @.23	2 53
			15 59	1 - 3/4"C Adapter	1 75
				1 - 3/4"C x 3/4"C Curb-cock	3 85
				1 - Box & Rod	3 35
				1 - 1/2" Offset Tail Piece	38
				Trucking 1 hr. @ .75	75
					13 91
	Labor				

Bill sent 9-2-50

Caldwell

15 57

No Charge

1 30

2 53

1 75

3 85

3 35

38

75

13 91

DATE \_\_\_\_\_

# TOWN OF LEXINGTON—BOARD OF PUBLIC WORKS

## WATER DIVISION

The undersigned applies for a supply of water at No. \_\_\_\_\_ St. and hereby agrees to comply with the rules and regulations as now, or at any future time, established by the Board of Selectmen.

Am't. of Estimate \$ \_\_\_\_\_


Owner \_\_\_\_\_

Am't. Paid \$ \_\_\_\_\_

Address \_\_\_\_\_

Builder \_\_\_\_\_

Sketch of Service Here

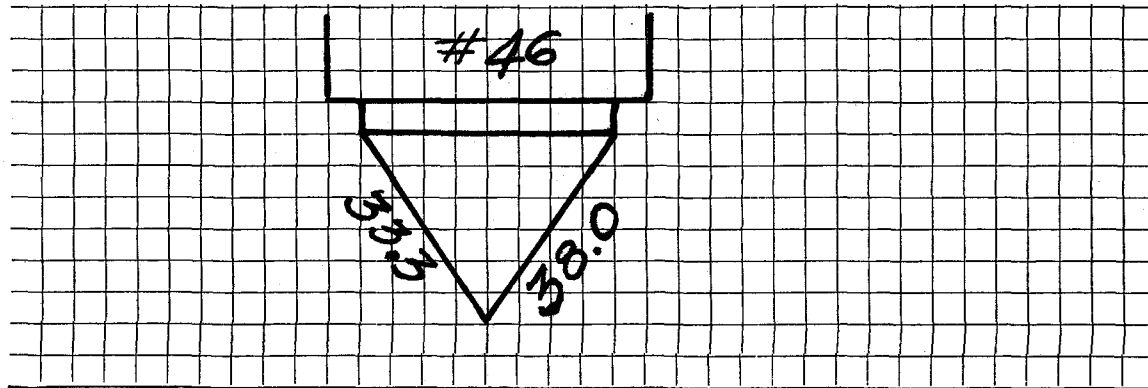

Connection made in \_\_\_\_\_ Street.

Work completed \_\_\_\_\_ 19

Remarks: