

WATER SERVICE RECORD

Name Daniel Gorman

Service No. 2

Address 47 Reed Street

Location

~~XXXXXXXXXXXX~~ - New Service W.O. #7797

Comm 5-27-63


Date	Material	Amount	Total	Date		Amount
4-15-63	Labor	2.42		3-11-63	Deposit	50.00
	10% O.H.	.24	2.66	5-27-63	Refund	19.33
	52' 3/4" Copper tubing @.42		21.84			30.67
	1 3/4" C x 1/2 I.W.H. Stop & Waste		<u>6.17</u>		NON CHARGE	
			30.67	4-15-63	Labor	2.31
1/27/63	10% O.H.				18' 3/4" Copper tubing @.42	7.56
					1 3/4" C Corp Cock	4.91
					1 3/4" C CurbbCock	6.28
					1 Box & Rod	4.90
					1 1/2 Straight tailpiece	.50
					1 1/2 Offset tailpiece	<u>.50</u>
						26.96

DATE _____

TOWN OF LEXINGTON — BOARD OF PUBLIC WORKS

WATER DIVISION

Sketch of Service Here

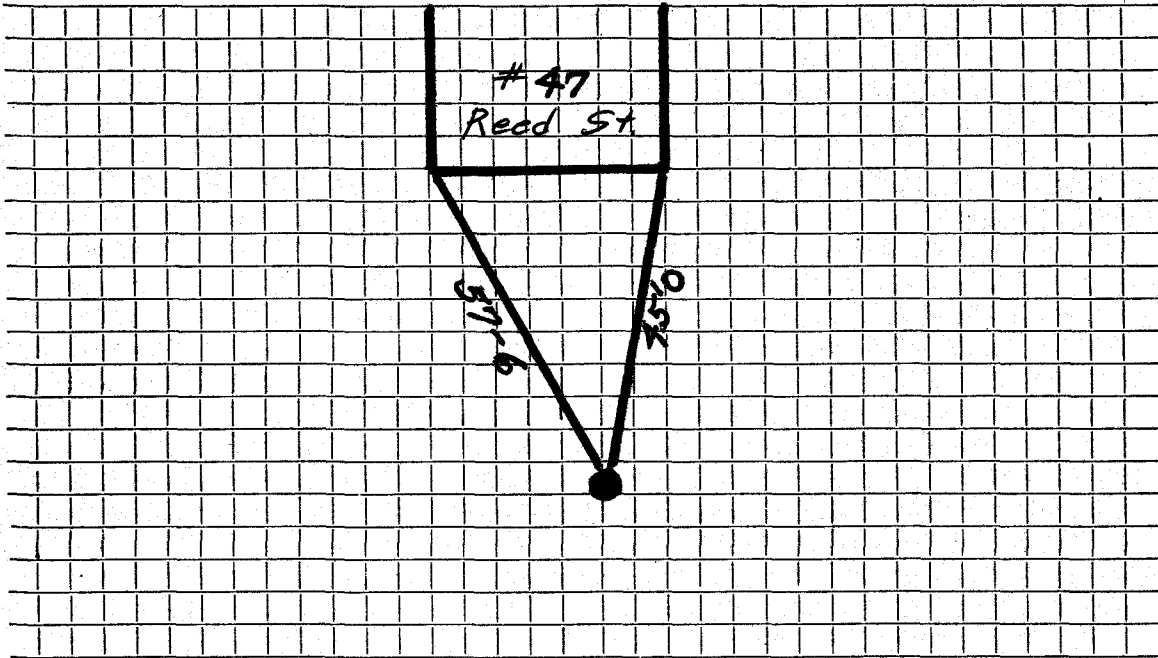

Connection made in Street. Work completed

Remarks:

.....

.....