

WATER SERVICE RECORD

#2018

Name Arthur Osborn

Service No. 193

Address 49-51 ~~Need Street~~ # 3195

Location


~~Renewal~~ - Renewal - ~~New Service~~

Comm 11-24-60

Date	Material	Amount	Total	Date		Amount
9-19-60	Labor	23.60		9-13-60	Deposit	100.00
	10% O.H.	2.36	25.96	11-24-60	Return	44.30
	25' 1" Copper tubing @.4676		11.69			<u>55.70</u>
	1 1" x 1" I.W.H. Stop & Waste		6.96		NON CHARGE	
	1 1" C x 3/4" C Bushing		.59	9-19-60	Labor	15.73
	1 hr. Pippin Shovel @4.50		4.50	23'	1" Copper tubing @.4676	10.75
	2 hrs. Trucking @3.00		<u>6.00</u>	1	1" C Corp Cock	7.31
			55.70	1	1" C Curb Cock	8.06
				1	3/4" Straight tailpiece	.70
				1	3/4" Offset tailpiece	.70
				1	hr. Pippin Shovel @4.50	4.50
				17	x 3 Patch	<u>17.00</u>
						64.75

TOWN OF LEXINGTON — BOARD OF PUBLIC WORKS
WATER DIVISION

Sketch of Service Here

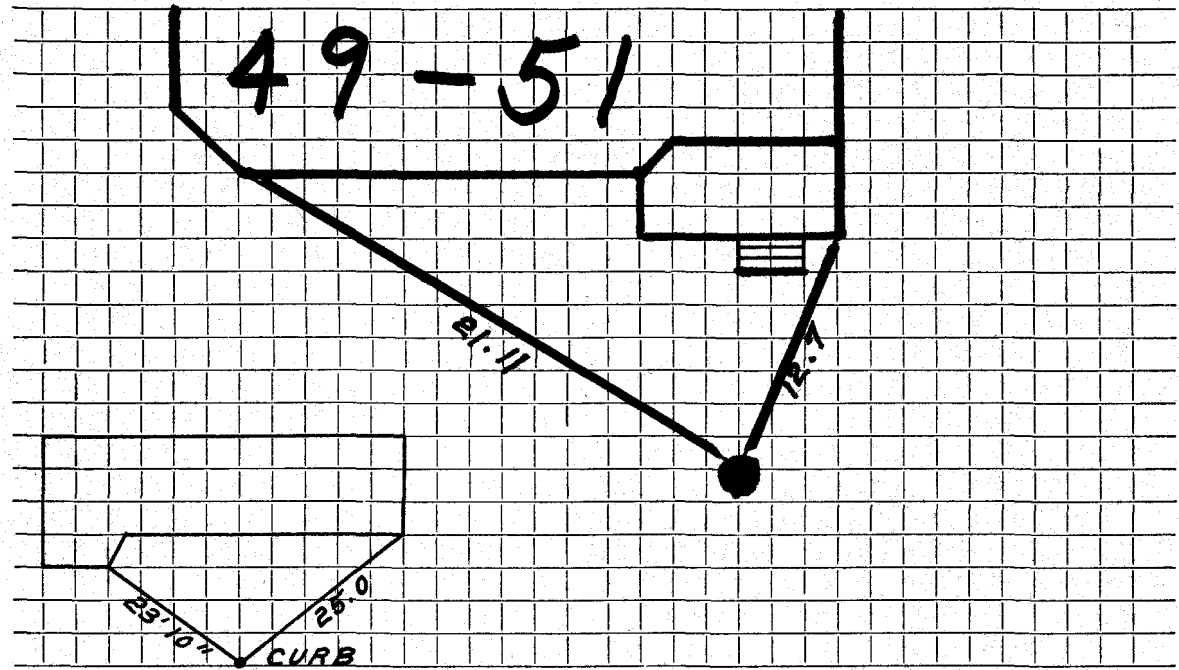

Connection made in Street. Work completed

Remarks:
.....
.....