

Name

Service No. 2305

Address 5 Reed St.

Location 5 Reed St. # 1605

Kind of Pipe

Size

Size of Main

Repair—Renewal—New Service

Location

Date	Material	Amount	Total	Date	Amount
3/27/1947	35' 3/4" Copper 1 3/4" 1/2 S&W 1 3/4" Union (2 pts)			1.5.00 Repair made to lead on the outside 3/4 Lead x 3/4 copper adapt 3/4" comp. curb	
	Labor				

DATE \_\_\_\_\_

# TOWN OF LEXINGTON—BOARD OF PUBLIC WORKS

## WATER DIVISION

The undersigned applies for a supply of water at No. \_\_\_\_\_ St. and hereby agrees to comply with the rules and regulations as now, or at any future time, established by the Board of Selectmen.

Am't. of Estimate \$ \_\_\_\_\_

Owner

Felix Viano


Am't. Paid \$ \_\_\_\_\_

Address

5 E. Reed St.

Builder \_\_\_\_\_

Sketch of Service Here

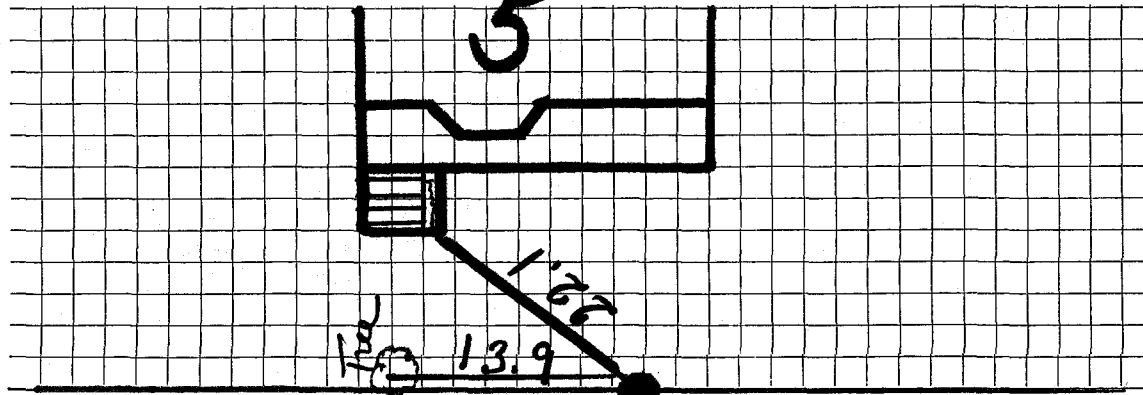

Connection made in \_\_\_\_\_

Street.

Work completed \_\_\_\_\_

19

Remarks:

65.4 pole