

WATER SERVICE RECORD

Name

Service No.

Address

55 Reed Street

Location


Repair—Renewal—New Service

Date		Material	Amount	Total	Date	Material	Amount
4/2/27	2	hrs. Labor @ .60	1.20				
		15% O.H.	.18	1.38			
	40'	1" G.I. Pipe @ .20		8.00			
	2	1" Ells @.15		30		OUTSIDE	
	2	1" S. Nipples @.10		20	7/22/86	22'10" 3/4" Copper	
	1	S & W		2.75		1 3/4" Curb	
				\$12.63		1 1" x 3/4" Iron to Copper	
						1 1" x 6" CL Nipple	
						1 1" Style 138	
						1 Box & Rod	

DATE _____

TOWN OF LEXINGTON — BOARD OF PUBLIC WORKS
WATER DIVISION

Sketch of Service Here

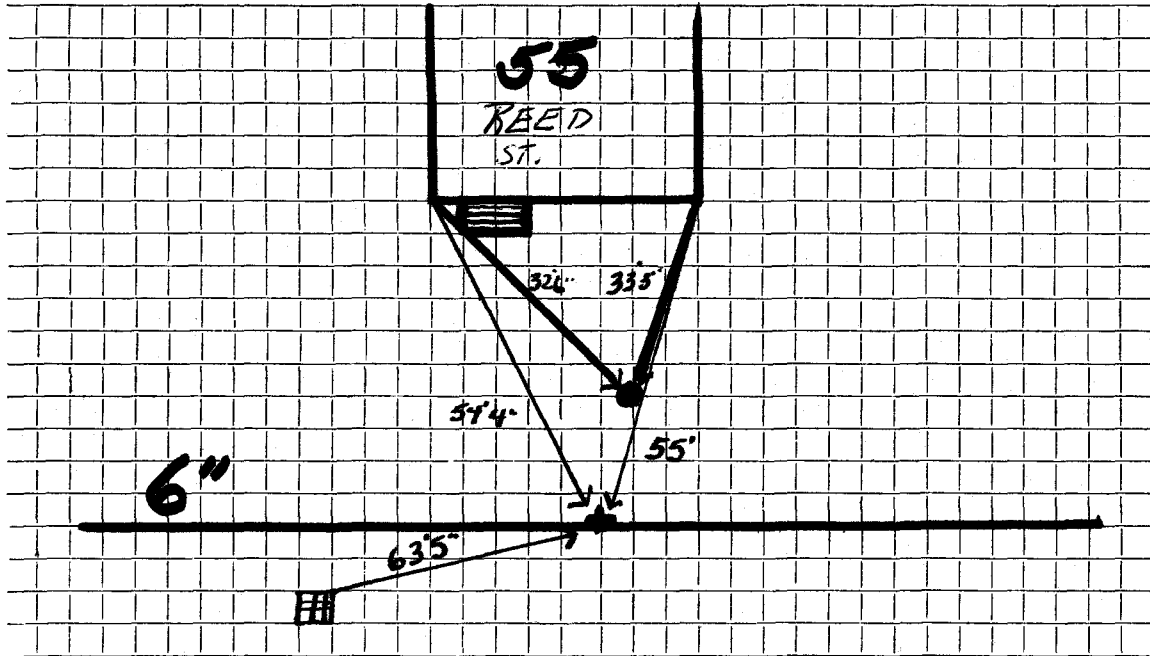

Connection made in Street. Work completed

Remarks:

.....
.....