

Name **Frederick Trimhold**Service No. **86**Address **57 Reed Street**

#5649

Lexington, Mass.

Location **57 Reed Street**

Kind of Pipe

Size

Size of Main

~~Repair-Renewal~~ **New Service**Com. **5-29-50**

Location

Date	Material	Amount	Total	Date	Amount
May 19, '50	Labor	1 30	1 30	May 9 '50	15 00
	10% Overhead		13	July 8 '50	.32
	34' - 3/4" Copper Tubing @.23		7 82		14 68
	1 - 3/4" C x 1/2" I.W.H. S&W		3 29		
	1 - 3/4" C x 3/4" C Union (3pts)		1 39	May 19, '50	1 30
	Trucking 1 hr. @.75		75	25' - 3/4" Copper Tubing @.23	5 75
			14 68	1 - 3/4" C Corp-cock	3 15
				1 - 3/4" C x 3/4" C Curb-cock	3 85
				1 - Box & Rod	3 60
				1 - 1/2" Straight Tail Piece	38
				1 - 1/2" Offset Tail Piece	38
				Littlefield Shovel 1 hr. @ 7.00	7 00
				Trucking 1 hr. @.75	75
	Labor				26 16

DATE _____

TOWN OF LEXINGTON – BOARD OF PUBLIC WORKS

WATER DIVISION

The undersigned applies for a supply of water at No..... St. and hereby agrees to comply with the rules and regulations as now, or at any future time, established by the Board of Selectmen.

Am't of Estimate \$.....

Owner


Am't Paid \$.....

Address

Builder

.....

Sketch of Service Here

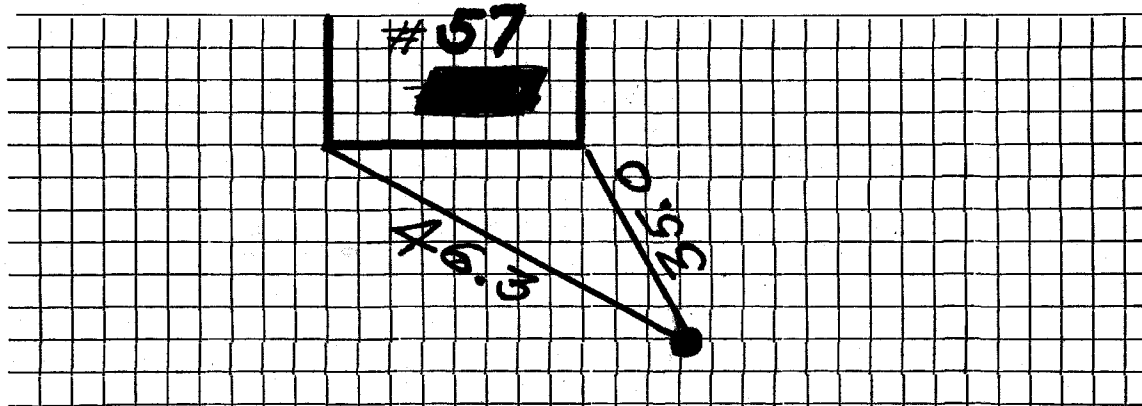

Connection made in Street.

Work completed19

Remarks: