

WATER SERVICE RECORD

Name Alfred Carpentieri

Service No. 226

Address 58 Reed Street

Location \_\_\_\_\_

xxx ~~Repair~~ - ~~Renewal~~ - ~~New Service~~

*Com. 9-20-54*


Date	Material	Amount	Total	Date	Amount
8/25/54	Labor	21 80		8-24-54	Deposited 50 00
	10% overhead	2 18	23 98	9-20-54	Refunded (2 02)
	55' - 3/4" copper tubing @ .35	19 25			47 98
	1 - 3/4" C x 1/2 I.W.H. stop & waste	4 00			
	1 hr. trucking		75		
			47 98		

DATE \_\_\_\_\_

TOWN OF LEXINGTON — BOARD OF PUBLIC WORKS

WATER DIVISION

Sketch of Service Here

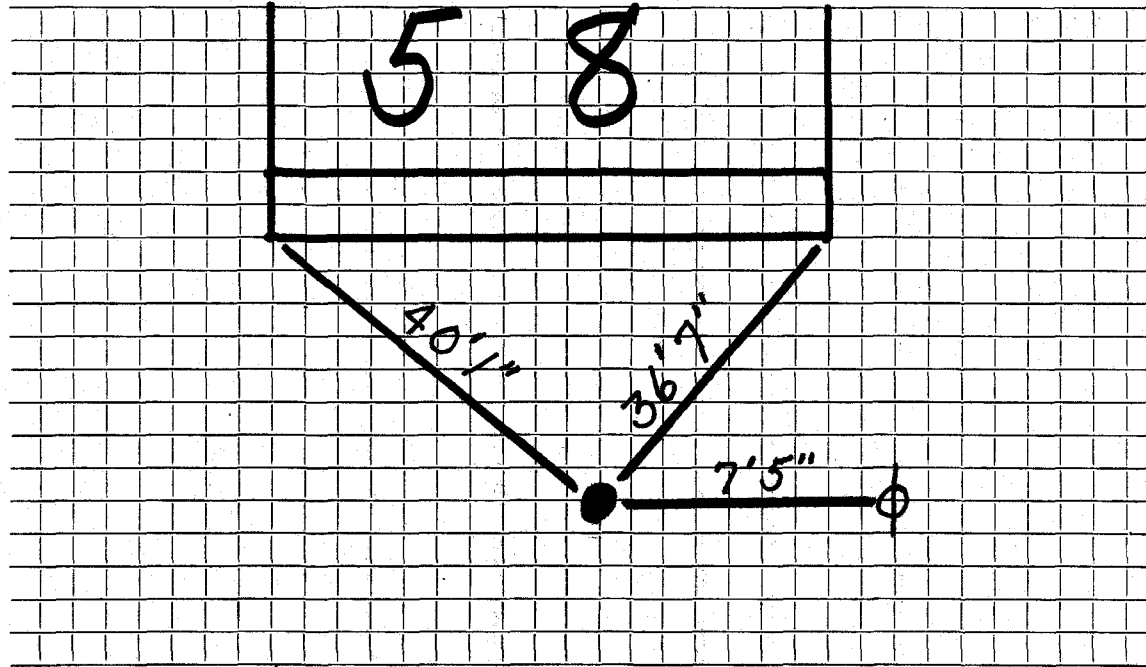

Connection made in ..... Street. Work completed .....

Remarks: .....

.....

.....