

WATER SERVICE RECORD

Name **William Moreau**

Service No. **184**

Address **59 Reed Street**

7542

Location

234

~~Right - Renewal - Not Inside~~

Comm 12-18-61


| Date | Material | Amount | Total | Date | Amount |
|----------|------------------------------|--------|-------|----------|-------------------------------|
| 11/27/61 | Labor | 2 04 | | 11-15-61 | 50 00 |
| | 10% O.H. | 20 | 2 24 | 12-18-61 | 21 76 |
| 40' | 3/4" Copper Tubing @ .42 | | 16 80 | | 28 21 |
| 1 | 3/4" Cx 1/2 IWH Stop & Waste | | 6 17 | | |
| 1 | Hr. Trucking @ 3.00 | | 3 00 | 11/27/61 | Labor 10 83 |
| | | | 28 21 | 23' | 3/4" Copper Tubing @ .42 9 66 |
| | | | | 1 | 3/4" C Corp Cock 4 91 |
| | | | | 1 | 3/4" C Curb Cock 6 28 |
| | | | | 1 | Bow & Rod 4 90 |
| | | | | 1 | 1/2" Straight Tailpiece 50 |
| | | | | 1 | 1/2" Offset Tailpiece 50 |
| | | | | 1 | Hr. Pippin Shovel @ 5.00 5 00 |
| | | | | | 12 X 3 Patch 12 00 |
| | | | | | <u>54 58</u> |

DATE _____

TOWN OF LEXINGTON — BOARD OF PUBLIC WORKS

WATER DIVISION

Sketch of Service Here

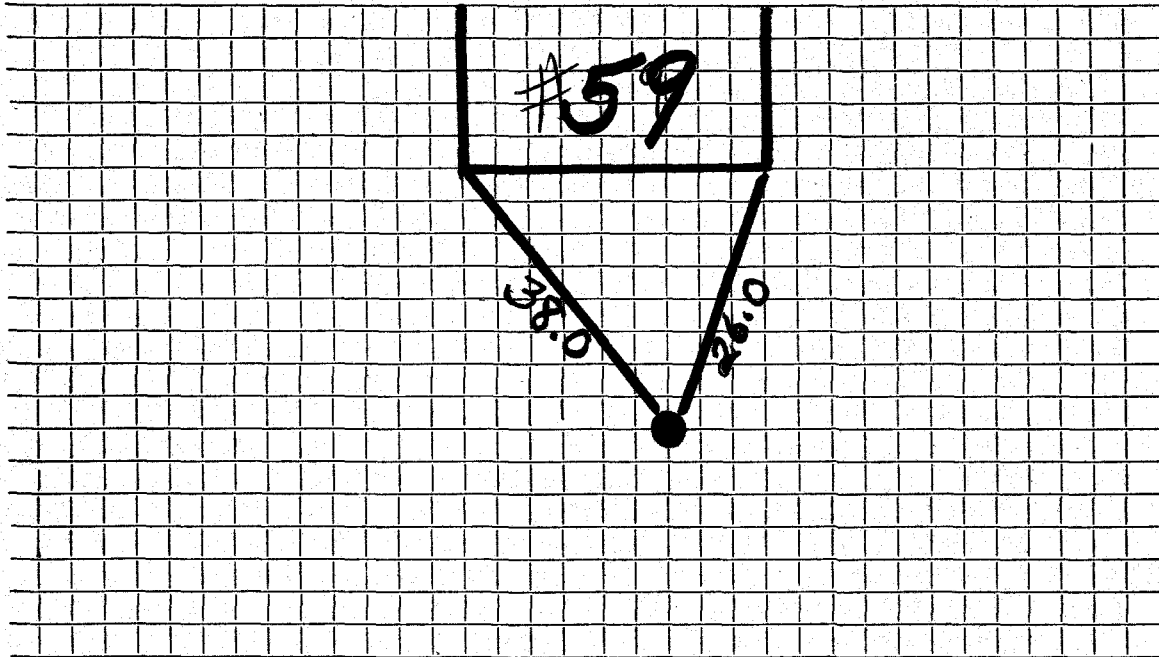

Connection made in Street. Work completed

Remarks:
.....
.....