

WATER SERVICE RECORD

4230

Name ~~Chispolm~~ Construction Company

Service No. 12

Address 6 Reed Street

6857

Location Lot #45

~~Repair~~ ~~Renewal~~ - New Service

JUL 25 1966

Date		Material	Amount	Total	Date		Amount
4-21-66		Labor	15.95		4-4-66	Deposit	50.00
4-27-66		"	8.08		7-27-66	Paid	36.24
4-27-66		"	6.40	30.43			<u>86.24</u>
			6.23	36.66			
	20'	3/4" Copper Tubing @.79		15.80			
	1	3/4" C Corp Cock		7.42			
	1	3/4" C Curb Cock		8.76			
	1	Box and Rod		5.10			
	2	hrs. Trucking		6.00			
	1	hrs. Town Shovel		6.50			
				86.24			
4-25-66	41'	3/4" Copper					


Bill sent 36.24

DATE _____

TOWN OF LEXINGTON — BOARD OF PUBLIC WORKS

WATER DIVISION

Sketch of Service Here

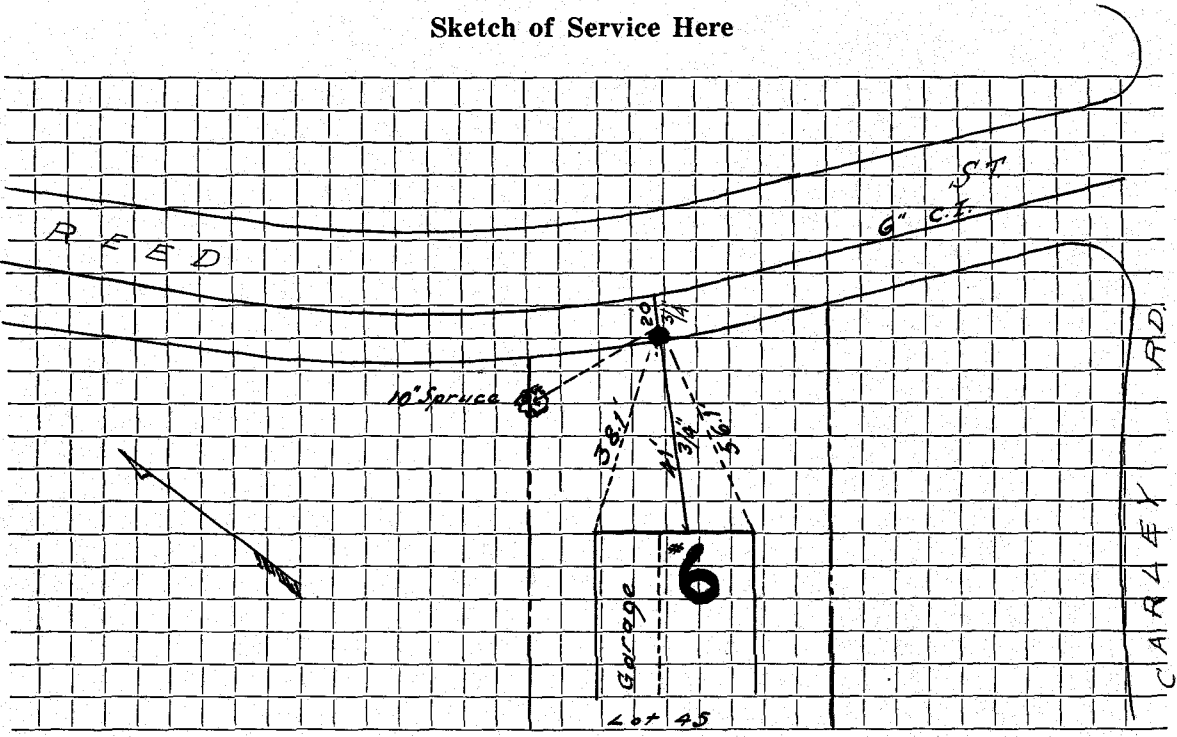

Connection made in Street. Work completed

Remarks:
.....
.....