

WATER SERVICE RECORD

Name

Service No.

Address

63 Reed Street

Location

~~Repair~~ — Renewal — ~~New Service~~


Date	Material	Amount	Total	Date	Amount
7-19-'27	38' 1" Gal. Pipe				
	1 1" S. Gal. Nipple				
	2 1" ELLs				
	1 Stop + Waste				
				5/1/84	24'
					3/4" Copper Tubing
				1	3/4" Corp.
				1	3/4" Curb
				1	1" LL Coupling
				1	1" x 5" CL Nipple
				1	1" Style 38
				1	Curb Box & Rod
				6	Yds. Gravel
				2	Ton Cold Patch

DATE _____

TOWN OF LEXINGTON — BOARD OF PUBLIC WORKS

WATER DIVISION

Sketch of Service Here

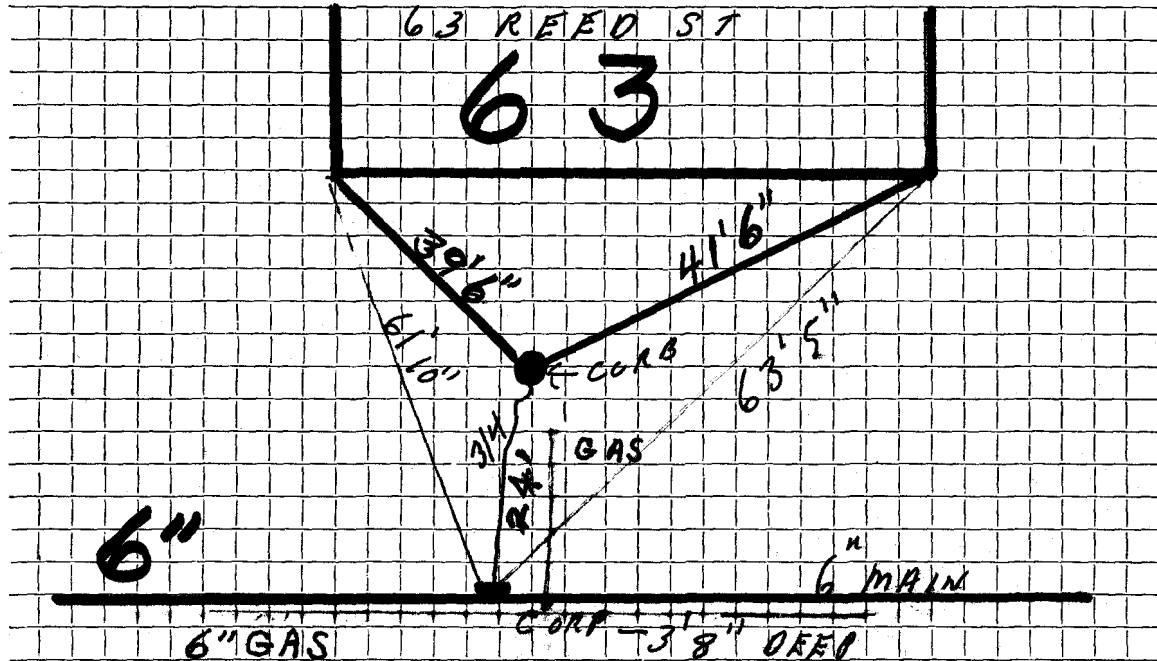

Connection made in Street. Work completed

Remarks: Original Service 7-19-27