

## WATER SERVICE RECORD

Name Ostland &amp; Bergquist

Service No. 250

Address 64 Reed Street

Location

~~Repair - Repair - New Service~~


Comm 12-14-59

Date	Material	Amount	Total	Date	Amount
10-13-59	Labor	1.85		10-5-59	50.00
	10% O.H.	.19	2.04	12-14-59	17.51
	56' 3/4" Copper tubing @.42		23.52		32.19
	1 3/4" C x 1/2 I.W.H. Stop & Waste		5.88		NON CHARGE
	1 hr. Trucking @.75		.75		Labor
			32.19		1.61
				4' 3/4" Copper tubing @.42	1.68
				1 3/4" C Corp Cock	4.67
				1 3/4" C Curb Cock	5.98
				1 Box & Rod	4.90
				1 1/2 Straight tailpiece	.50
				1 1/2 Offset tailpiece	.50
					19.84

TOWN OF LEXINGTON — BOARD OF PUBLIC WORKS

**WATER DIVISION**

Sketch of Service Here

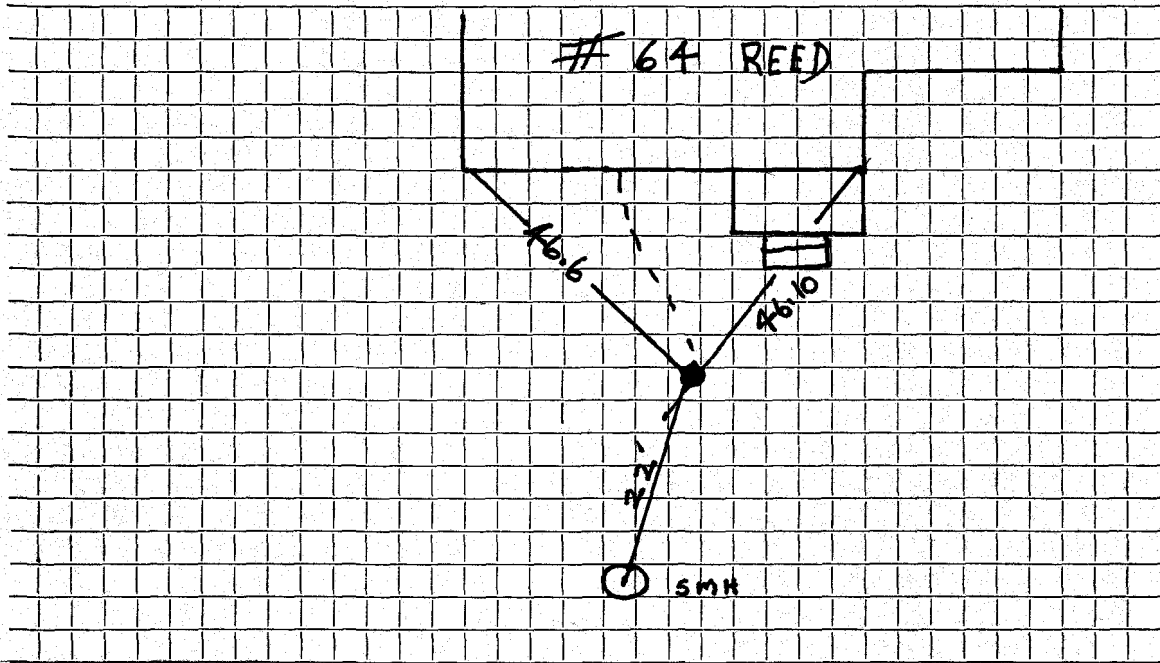

Connection made in ..... Street. Work completed .....

Remarks: .....  
.....  
.....