

Name A. S. Peckman

Service No.

134

Address 67 Reed Street

#4011

Lexington, Mass.

Location 67 Reed Street

Kind of Pipe

Size

Size of Main

Repair—Renewal—New Service

Location

Date	Material	Amount	Total	Date	Location	Amount
Aug. 4, '48	Labor	2 85	2 85	Aug 2 '48	Reported	50 00
5	"	1 15	1 15	Aug 2 '48	Reported	2 55
	10% Overhead		40		Non-Charge	42 81
	38' - 3/4" Copper Tubing @.255	9 69	9 69	Aug. 4, '48	Labor	19 33
	1 - 3/4" C x 3/4" I.W.H. S & W	3 15	3 15	5		21 35
	1 - 3/4" C x 3/4" J Union(3pts)	1 32	1 32	26' - 3/4" Copper Tubing @.255		6 63
	Trucking 1 hr. @.75		75	1 - 3/4" J Corp-cock		3 00
	Patching 23 x 3		23 00	1 - 3/4" C x 3/4" C Curb-cock		3 68
			42 31	1 - Box & Rod		3 55
				1 - 3/4" Offset Tail Piece		30
				1 - 3/4" Straight Tail Piece		30
				Compressor 2 hrs. @ 1.75		3 50
				Trucking 1 hr. @.75		75
						62 39

Com. 10/05/48

Labor

DATE \_\_\_\_\_

# TOWN OF LEXINGTON—BOARD OF PUBLIC WORKS

## WATER DIVISION

The undersigned applies for a supply of water at No. \_\_\_\_\_ St. and hereby agrees to comply with the rules and regulations as now, or at any future time, established by the Board of Selectmen.

Am't. of Estimate \$ \_\_\_\_\_


Owner \_\_\_\_\_

Am't. Paid \$ \_\_\_\_\_

Address \_\_\_\_\_

Builder \_\_\_\_\_

Sketch of Service Here

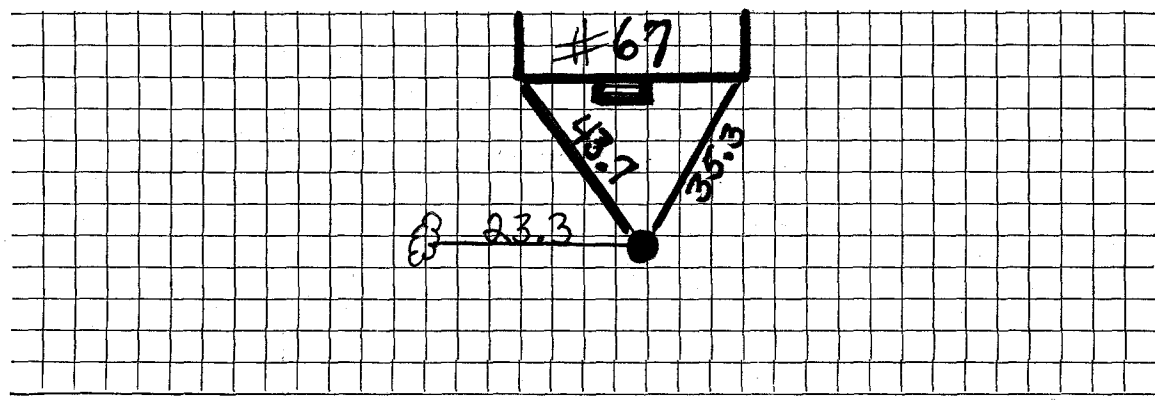

Connection made in \_\_\_\_\_ Street.

Work completed \_\_\_\_\_ 19

Remarks: