

WATER SERVICE RECORD

Name

Service No.

Address 71 Reed ST

Location

Repair—Renewal—New Service


Date	Material	Amount	Total	Date	Material	Amount
5-12-31	40' 1" C.h. Pipe			8-12-97	24.6 - 3/4 Copper	
	3 1" h.h. Couplings				1 - 3/4 Corp	
	2 1" h.h. ELBs				1 - 3/4 Curb.	
	1 Stop + Waste				1 - Box	
					1 - 1 x 3/4 C.I. Adp	
				9-2-05	36' - 1" Copper	

DATE 8.20.97

TOWN OF LEXINGTON — BOARD OF PUBLIC WORKS

WATER DIVISION

Sketch of Service Here

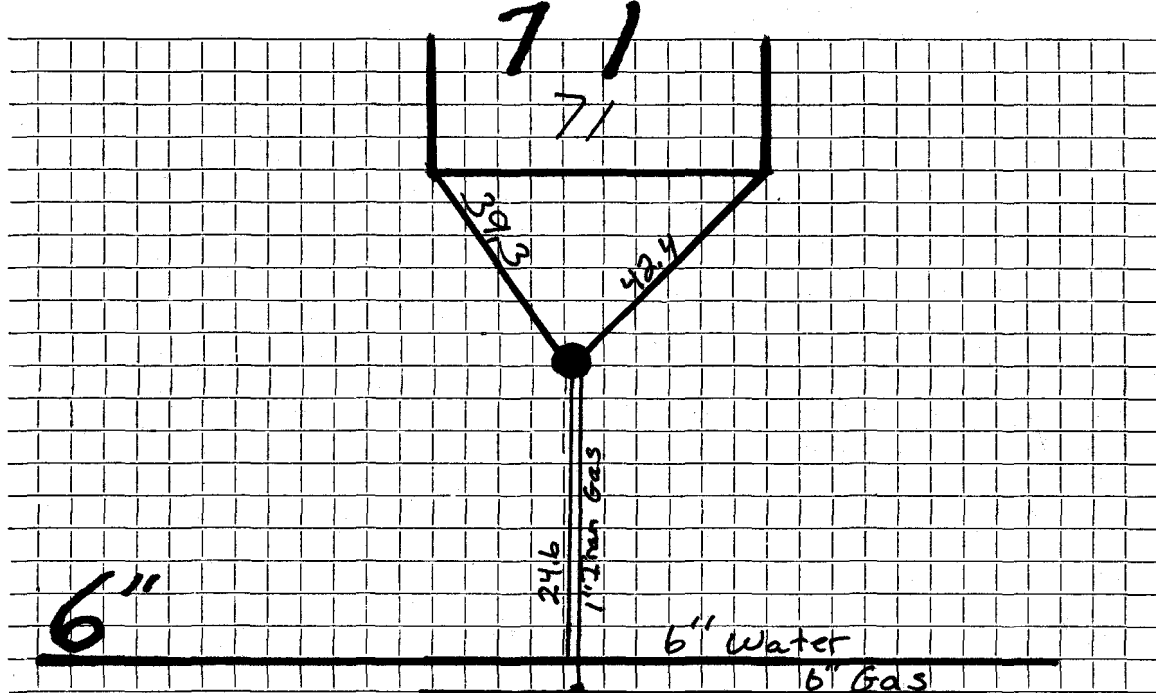

Connection made in Street. Work completed ... 8:12:97.....

Remarks: ... Gas main ... 6" ... lower ... than ... water ... Gas Service ... Just above ...
water service