

## WATER SERVICE RECORD

Name Ogden Construction Corporation

Service No. 186

Address 75 Reed St., Lexington, Mass.

Location

~~Repair~~ New Service


Comm 12-31-61

Date	Material	Amount	Total	Date	Amount	
12/8/61	Labor	2 04		11-27-61	Deposit	50 00
	10% O.H.	20	2 24	12-31-61	Re-Sund	21 43
	48' 3/4" Copper Tubing @ .42		20 16			28 57
	1 3/4" C x 1/2 IWH Stop & Waste		6 17			
			28 57			
				12/8/61	Labor	1 69
					28' 3/4" Copper Tubing @ .42	11 76
					1 3/4" C Corp Cock	4 91
					1 3/4" C Curb Cock	6 28
					1 Box & Rod	4 90
					1 1/2 Straight Tailpiece	50
					1 1/2 Offset Tailpiece	50
						30 54

TOWN OF LEXINGTON — BOARD OF PUBLIC WORKS

**WATER DIVISION**

Sketch of Service Here

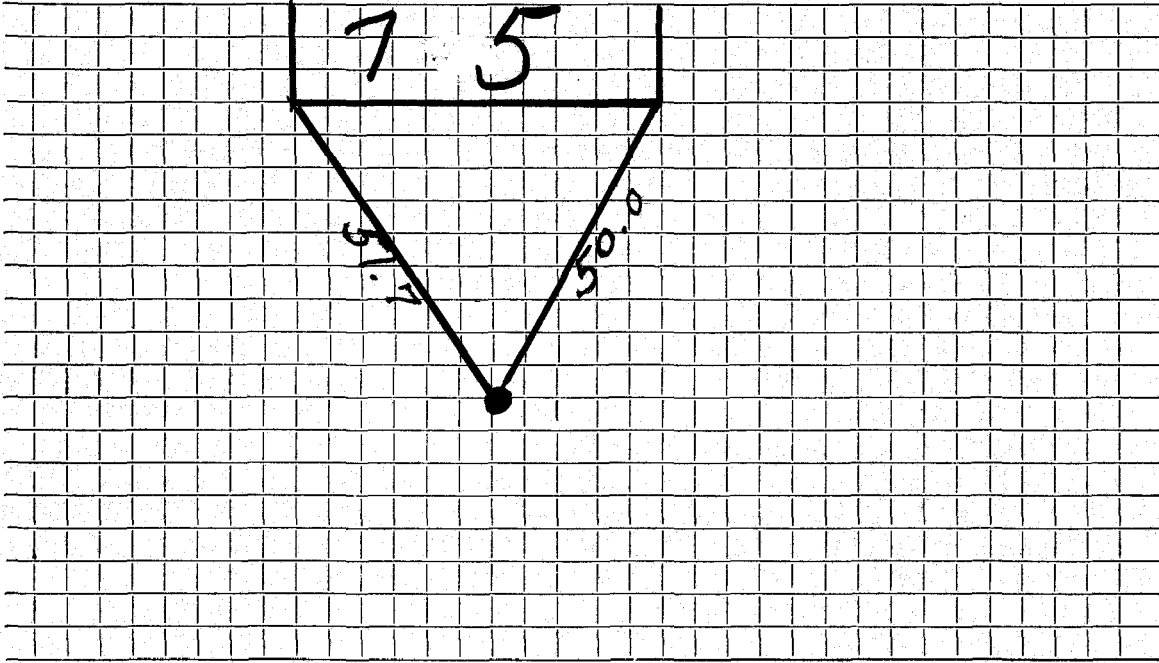

Connection made in ..... Street. Work completed .....

Remarks: .....  
.....  
.....