

WATER SERVICE RECORD

#4275

Name Mrs. Christopher St. George

Service No. 28

Address 76 Reed Street

Location

~~Repair—Renewal—New Service~~


Comm 6-16-41

Date	Material	Amount	Total	Date		Amount
4-20-61	Labor	52.12		5-6-41	Deposit	100.00
	10% O.H.	5.21	57.33	6-16-41	Retained	15.13
36'	3/4" Copper Tubing@.42		15.12		NON CHARGE	84.87
1	3/4 Cx 1/2 I.WH. Stop & Waste		6.17	4-20-61	Labor	20.27
1/2	Hr. Town Shovel @6.50		3.25	14'	3/4" Copper Tubing @.42	5.88
1	Hr. Trucking @3.00		3.00	1	3/4" Copper Corp Cock	4.91
			<u>84.87</u>	1	3/4" C Curb Cock	6.28
				1	Box & Rod	4.90
				1/2	Hr. Town Shovel @6.50	3.25
					2 x 3 Patch	<u>2.00</u>
						47.49

TOWN OF LEXINGTON — BOARD OF PUBLIC WORKS

WATER DIVISION

Sketch of Service Here

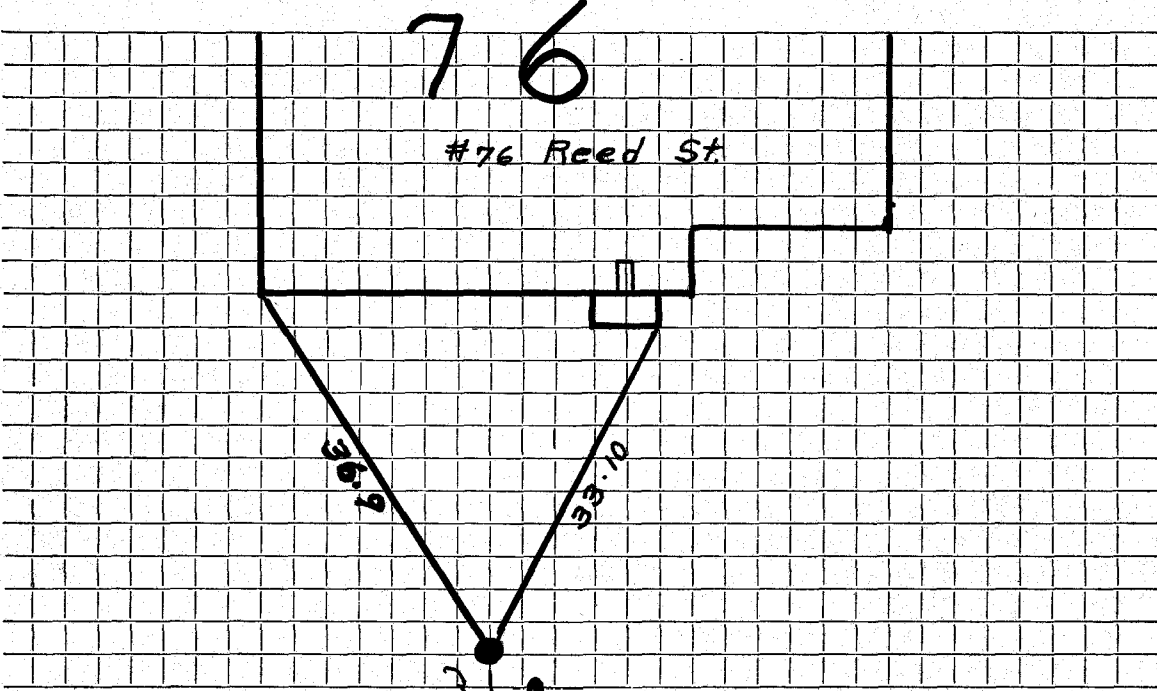

Connection made in Street. *old* Work completed

Remarks:
.....
.....