

Name **Edgar R. McLalan**

WATER SERVICE RECORD

Service No. 198 2785

Address **79 Reed Street**Location **Lexington**~~Repair - Renewal~~ - New Service*Com. 11-3-52*


Date	Material	Amount	Total	Date	Amount
10/2/52	Labor	3 60		9-4-52	60 -
	10% Overhead	36	3 96	11-5-52	63 89
	60' - 3/4" Copper tubing @ .34	20 40			<u>56 11</u>
	1 - 3/4" C x 1/2 I.W.H. stop & waste	4 00		10/2/52	Labor 3 60
	1 hr. Littlefield shovel		7 00	28' - 3/4" Copper tubing @ .34	9 52
	1 hr. trucking		75	1 - 3/4" C. Corp-cock	4 33
	patching 20 X 3		20 00	1 - 3/4" C x 3/4" C. curb-cock	4 67
			56 11	1 box and rod	3 90
				1 - 1/2 offset tail piece	50
				1 - 1/2 straight tail piece	50
				3 hrs. Littlefield shovel	21 00
				1 hr. trucking	75
					<u>48 77</u>

DATE _____

TOWN OF LEXINGTON — BOARD OF PUBLIC WORKS

WATER DIVISION

Sketch of Service Here

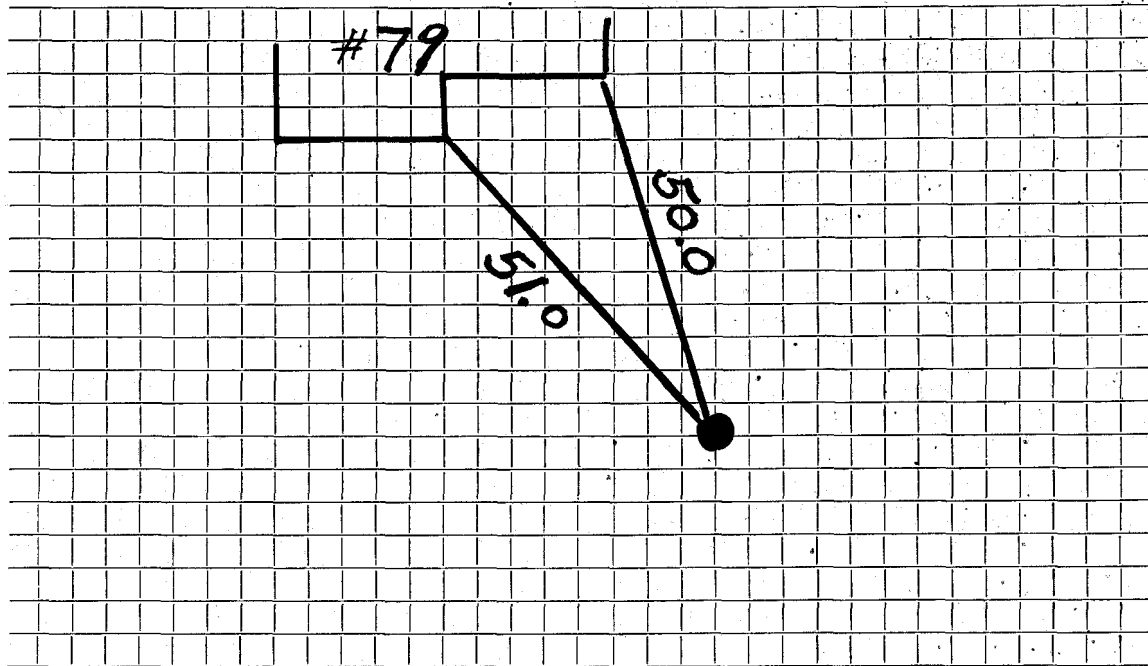

Connection made in Street. Work completed

Remarks :
.....
.....