


DATE _____

TOWN OF LEXINGTON — BOARD OF PUBLIC WORKS
WATER DIVISION

Sketch of Service Here

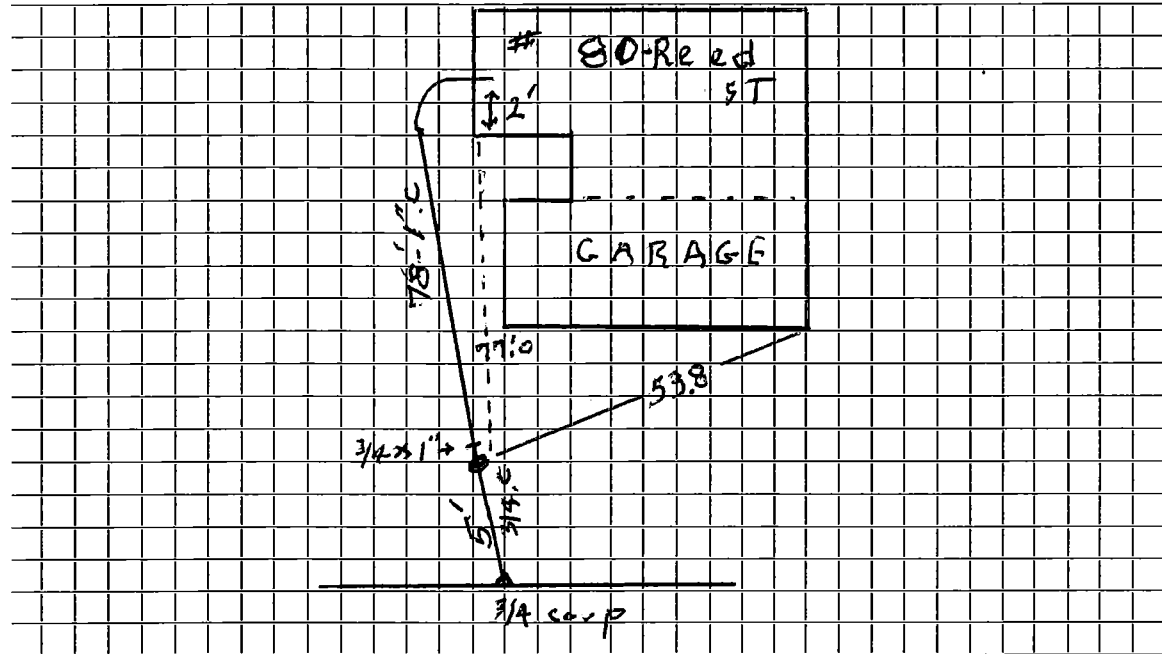

Connection made in..... Street.

Work completed 12/14/11 J. Melany

Remarks:.....

.....

.....