

WATER SERVICE RECORD

Name Dennis J. Carroll

Service No.

66

Address 81 Reed St.

Location Lexington

~~REPAIRS~~ - New Service

COM. 5-18-53


Date	Material	Amount	Total	Date	Amount
4/24/53	Labor	7 17		4-8-53	Deposited 100 00
	10% overhead	72	7 89	5-18-53	Refunded 13 92
	41'-3/4" Copper Tubing @ .34		13 94		NON-CHARGE 56 08
	1-3/4" C x 1/2 I.W.H. stop & waste		4 00	4/24/53	Labor 15 00
	1 Hr. Littlefield Shovel		7 50		28'-3/4" Copper tubing @ .34 9 52
	1 Hr. Trucking		75		1-3/4" C. Corp-cock 4 33
	Patching 22 x 3		22 00		1-3/4" C x 3/4" C. Curb cock 4 67
			56 08		1-Box & Rod 3 90
					1-1/2 offset tail piece 50
					1-1/2 straight tail piece 50
					3 Hr. Littlefield Shovel @ 7.50 22 50
					1 Hr. Trucking 75
					<u>61 67</u>

DATE \_\_\_\_\_

TOWN OF LEXINGTON — BOARD OF PUBLIC WORKS

**WATER DIVISION**

Sketch of Service Here

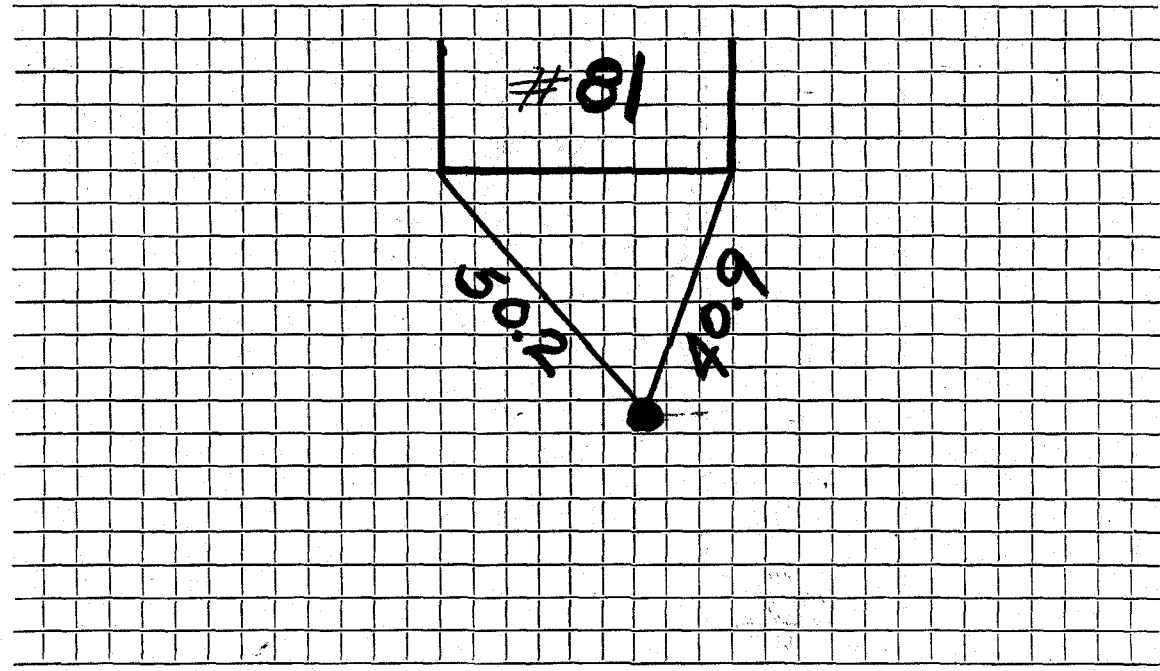

Connection made in ..... Street.      Work completed .....

Remarks: .....  
.....  
.....