

Name E. J. Harris

8790

WATER SERVICE RECORD

Service No. 136

5143
4536

Address 84 Reed Street

Location Lexington, Mass.

~~Repair/General~~ - New Service


Com. 9-24-51

Date	Material	Amount	Total	Date	Material	Amount
7-11-51	Labor	2 76	2 76	6-22-51	Deposited	50 00
	10% Overhead		28	9-24-51	Re-funded	11 91
	50'-3/4" Copper Tubing @.326	16 30				38 09
	1-3/4" Cx 1/2" I.W.H. S&W	4 00			No Charge	
	2 Hr. Littlefield Shovel	14 00		7-11-51	Labor	2 76
	1 Hr. Trucking		75	5'-3/4" Copper Tubing @.326		1 63
			38 09	1-3/4" C Corp-Cock		4 33
				1-3/4" Cx 3/4" C Curb-Cock		4 67
				1 Box & Rod		4 68
				1-1/2 Straight Tail Piece		50
				1-1/2 Offset Tail Piece		50
				1 Hr. Littlefield Shovel		7 00
				1 Hr. Trucking		75
						26 82

DATE _____

TOWN OF LEXINGTON — BOARD OF PUBLIC WORKS
WATER DIVISION

Sketch of Service Here

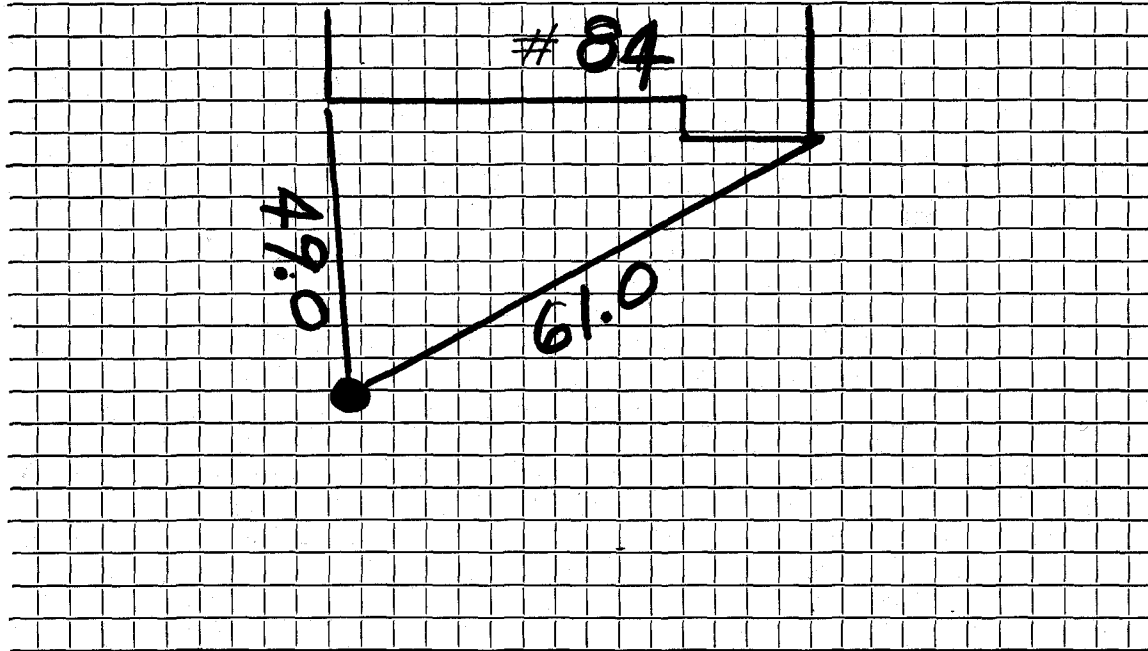

Connection made in Street. Work completed

Remarks:
.....
.....