

Name Mrs. D. J. Carroll

Service No.

259

Address 88 Reed Street

#7247

Lexington, Mass.

Location 88 Reed Street

Kind of Pipe

Size

Size of Main

~~XXXXXX~~ - New Service

Com. 12-31-19

Location

Date	Material	Amount	Total	Date	Amount
Dec. 9, '49	Labor	1 35	1 35	Dec 5 '49	20 00
	10% Overhead		14	Dec 21 '49	6 55
	33' - 3/4" Copper Tubing @.24		7 92		No Charge
	1 - 3/4" C x 1/2" I.W.H. S&W		3 29	Dec. 9, '49	Labor
	Trucking 1 hr. @.75		75		8 65
			13 45	5' - 3/4" Copper Tubing @.24	1 20
				1 - 3/4" C Corp-cock	3 15
				1 - 3/4" C x 3/4" C Curb-cock	3 85
				1 - Box & Rod	3 75
				1 - 1/2" Straight Tail Piece	87
				1 - 1/2" Offset Tail Piece	87
				Littlefield Shovel 2 hrs. @ 7.00	14 00
					36 09
	Labor				

DATE \_\_\_\_\_

TOWN OF LEXINGTON – BOARD OF PUBLIC WORKS

**WATER DIVISION**

The undersigned applies for a supply of water at No..... St. and hereby agrees to comply with the rules and regulations as now, or at any future time, established by the Board of Selectmen.

Am't of Estimate \$.....

Owner .....


Am't Paid \$.....

Address .....

Builder .....

.....

Sketch of Service Here

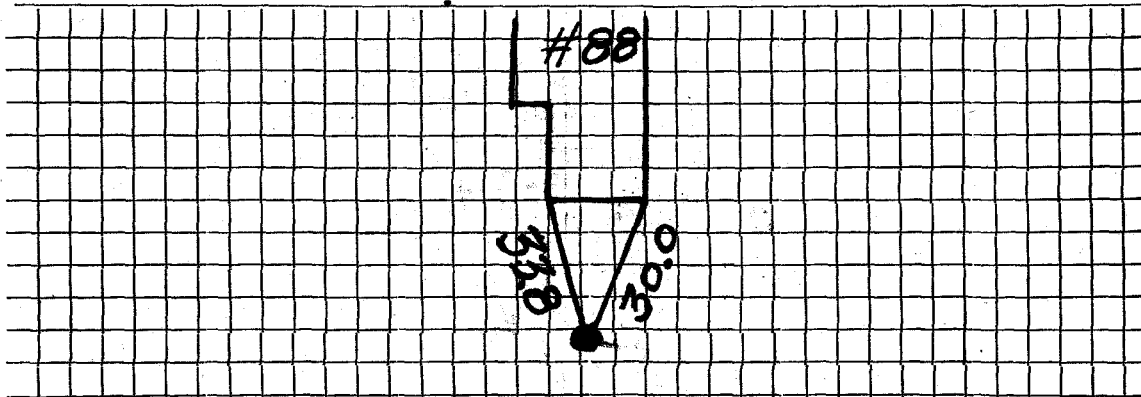

Connection made in ..... Street.

Work completed .....19

Remarks: