




DATE 11/4/19

TOWN OF LEXINGTON — BOARD OF PUBLIC WORKS

WATER DIVISION

Sketch of Service Here

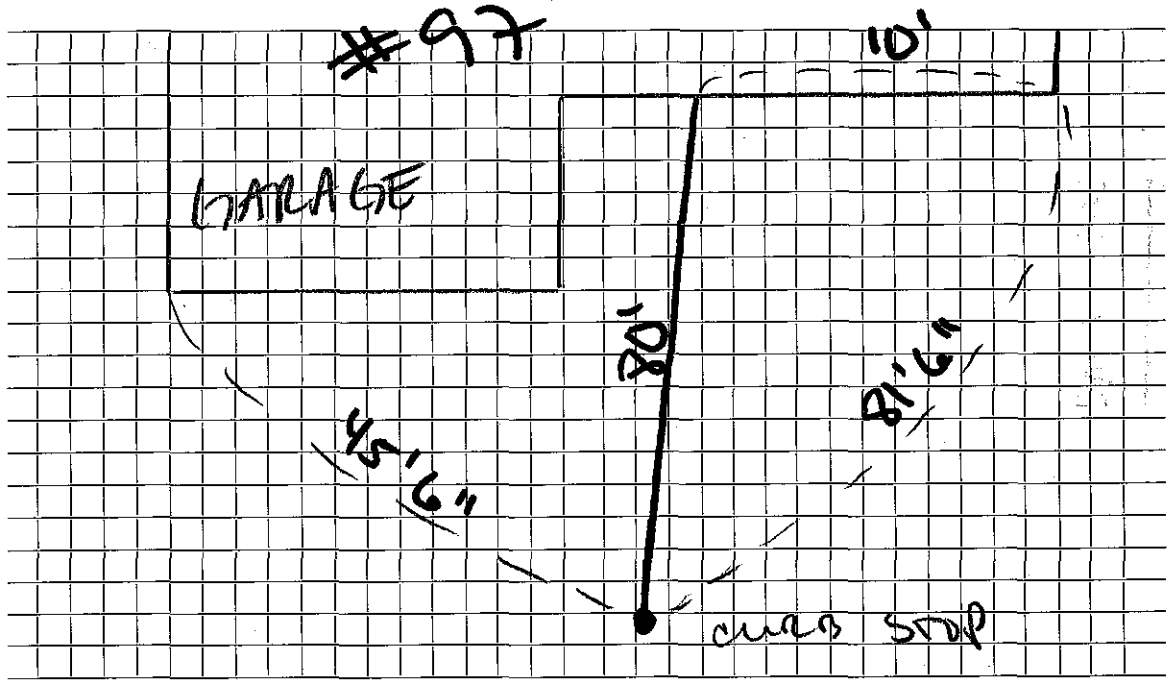

Connection made in Reed Street. Work completed .....

Remarks: .....