

Name *Paul Martus*

WATER SERVICE RECORD

Service No.

Address 98 Reed Street

Location


~~Repair—Renewal—New Service~~ Valeri #1919

Date	Material	Amount	Total	Date	Amount
11-5-64	CURB TO MAIN Labor	48.11			
	10% O.H.	4.81	52.92		
12'	3/4" Coppertubing @.42		5.04		
1	3/4" Curb Cock		8.76		
1	Style 38 Clamp		2.60		
1	C. L. Mipple		.65	XXXX 11/8/71	Labor 16 70
1	hr. Town Shovel		6.50	39'	3/4" Copper pipe .79 30 81
2	hrs. Trucking @3.00		6.00	1	3/4" Corperation 9 57
			82.47	1	Curb cock 11 32
10-14-71	40' 3/4" Copper tubing			1	Box & Rod 5 0
				1	Hr. Trucking 3 00
					<u>76 30</u>

TOWN OF LEXINGTON — BOARD OF PUBLIC WORKS

WATER DIVISION

Sketch of Service Here

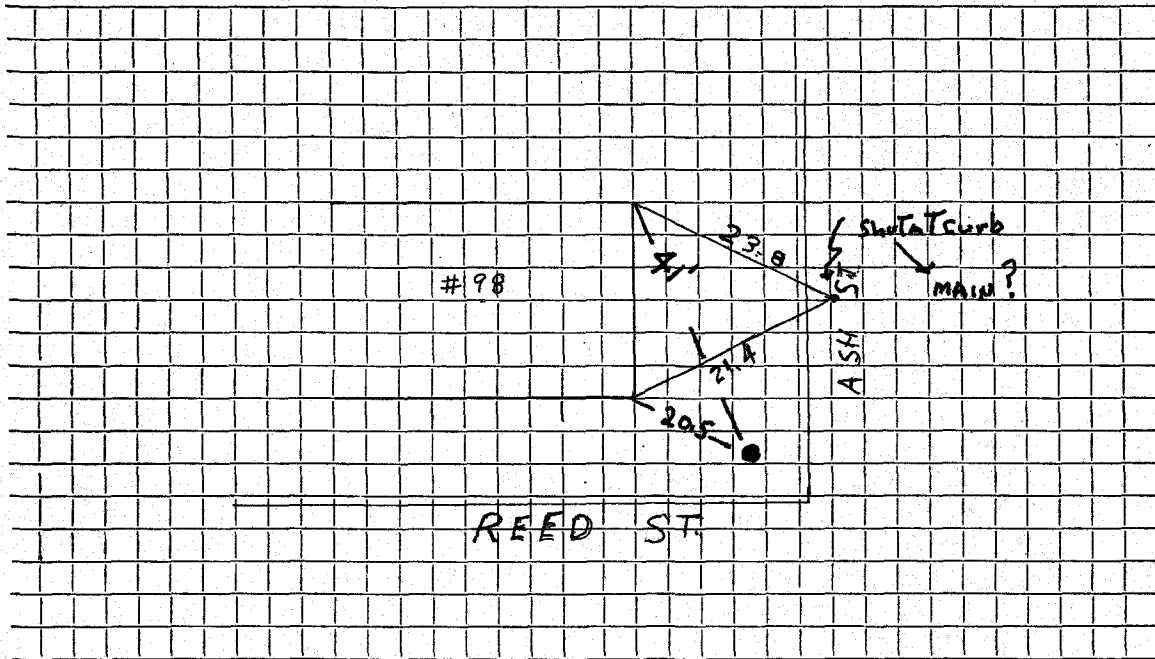

Connection made in Street. Work completed

Remarks:

.....

.....