


DATE 2/14/17

TOWN OF LEXINGTON — BOARD OF PUBLIC WORKS

WATER DIVISION

Sketch of Service Here

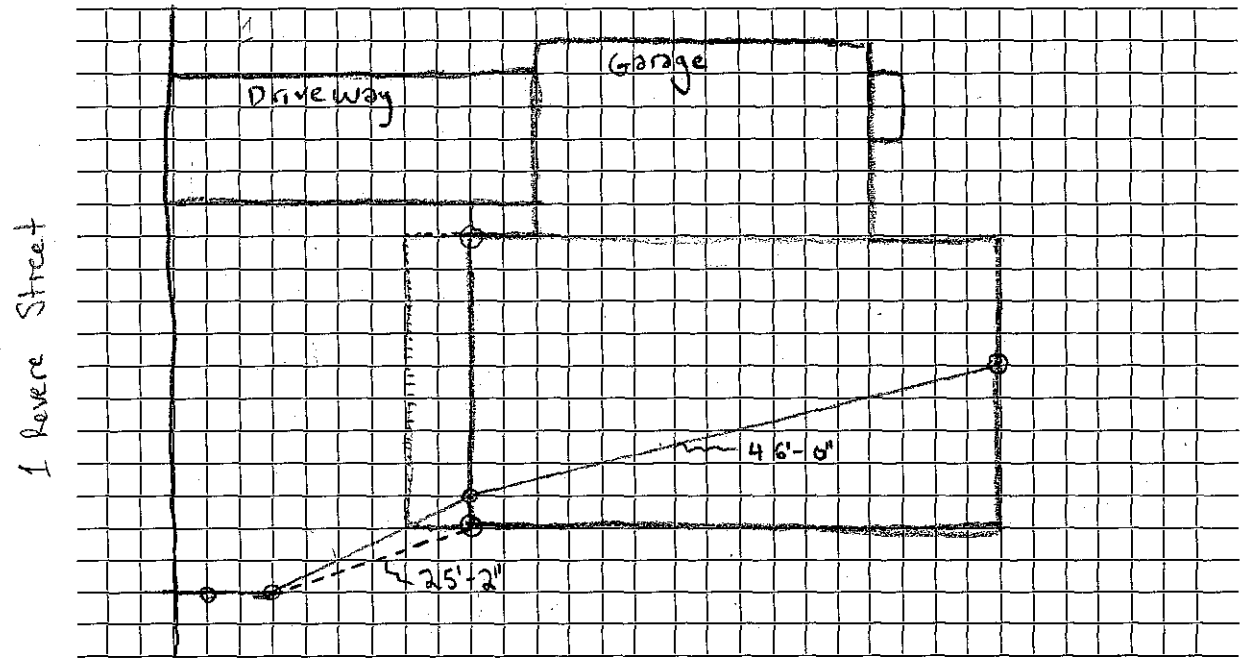

Connection made in 1 Revere Street Street. Work completed

Remarks: