

Name **Lesland Construction Company**

Service No. 60 2684

Address ¹⁸ Revere Street

Lexington, Mass.

Location ¹⁸ Revere Street

Kind of Pipe

Size

Size of Main

~~XXXXXXXXXXXX~~ New Service

Com. 5-29-50

Location

Date	Material	Amount	Total	Date	Amount
May 5, '50	Labor	3 60	3 60	April 20 '50	56 00
	10% Overhead		36	Jan 5 '50	9 57
	48' - 3/4" Copper Tubing @.23	11 04			47 43
	1 - 3/4" C x 1/2" I.W.H S&W		3 29		
	1 - 3/4" C x 3/4" C Union (3pts)		1 39	May 5, '50	3 60
	Littlefield Shovel 1 hr. @ 7.00	7 00		24' - 3/4" Copper Tubing @.23	5 52
	Trucking 1 hr. @.75		75	1 - 3/4" C Corp-cock	3 15
	Patching 20 x 3		20 00	1 - 3/4" C x 3/4" C Curb-cock	3 85
			47 43	1 - Box & Rod	3 60
				1 - 1/2" Offset Tail Piece	38
				1 - 1/2" Straight Tail Piece	38
				Littlefield Shovel 1 hr. @ 7.00	7 00
				Trucking 1 hr. @.75	75
	Labor				28 23

DATE _____

TOWN OF LEXINGTON – BOARD OF PUBLIC WORKS

WATER DIVISION

The undersigned applies for a supply of water at No..... St. and hereby agrees to comply with the rules and regulations as now, or at any future time, established by the Board of Selectmen.

Am't of Estimate \$.....

Owner


Am't Paid \$.....

Address

Builder

.....

Sketch of Service Here

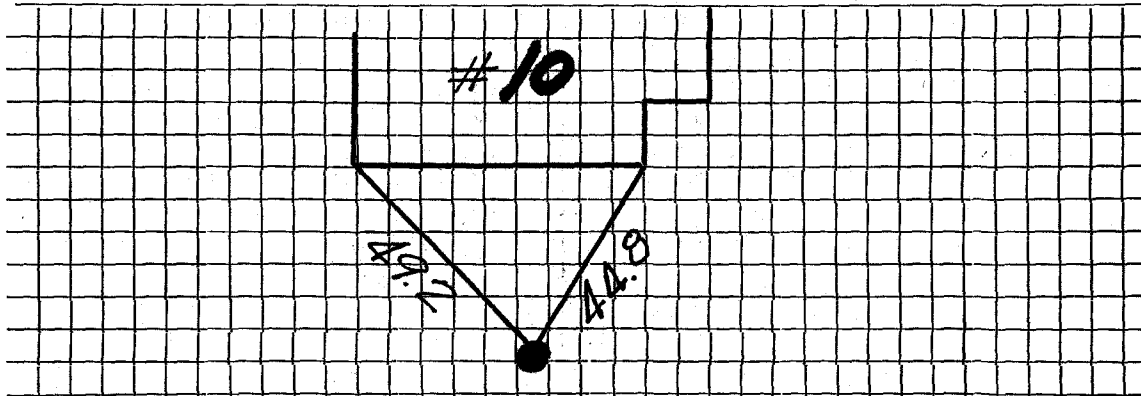

Connection made in Street.

Work completed19

Remarks: