


DATE 5/10/2012

TOWN OF LEXINGTON — BOARD OF PUBLIC WORKS WATER DIVISION

Sketch of Service Here

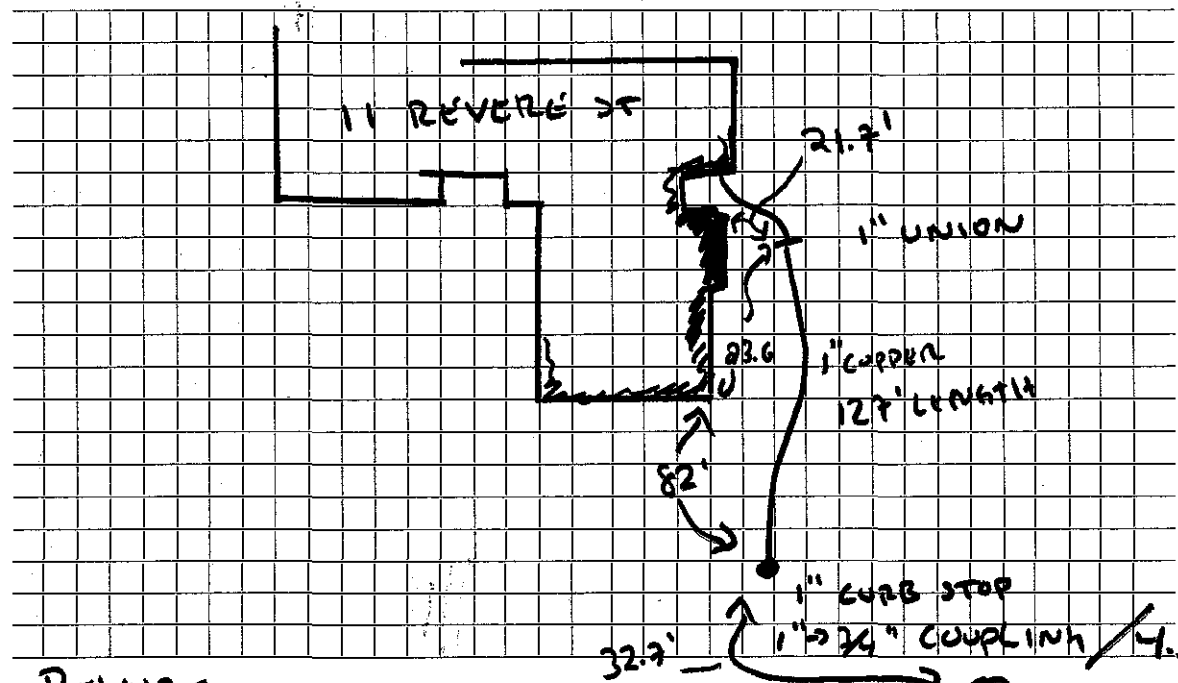

Connection made in REVERE Street. Work completed by SMITH (U.T.I. CON.) CONTRACTOR

Remarks: OLD 3/4 CURB DURIKO LEFT ON