

WATER SERVICE RECORD

Name Louis Tropeano

Service No. 242

Address 12 Revere St.

Location Lexington

~~Repair/Removal~~ - New Service

*Com. 9-14-53*

Date	Material	Amount	Total	Date	Amount
8/19/53	Labor	8 75		8-13-53	2.50
	10% overhead	88	9 63	9-14-53	(32 30)
	40'-1" Copper Tubing @.48		19 20		52 70
	1-1" C x 1" I.W.H. STOP & WASTE		5 12	8/19/53 Labor	10 00
	2 Hr. Littlefield Shovel @7.50		15 00	12'-1" Copper Tubing @.48	5 76
	1 Hr. Trucking		75	1-1" C. Corp-cock	5 61
	Patching 3 x 3		3 00	1-1" C x 1" C. Curb-cock	6 80
			52 70	1-Box & Rod	3 90
				1-1" Straight tail piece	50
				1-1" offset tail piece	50
				1 Hr. Littlefield Shovel	7 50
				1 Hr. Trucking	75
					<u>41 32</u>



*Deposited*  
*Refunded*

NON CHARGE

TOWN OF LEXINGTON — BOARD OF PUBLIC WORKS

WATER DIVISION

Sketch of Service Here

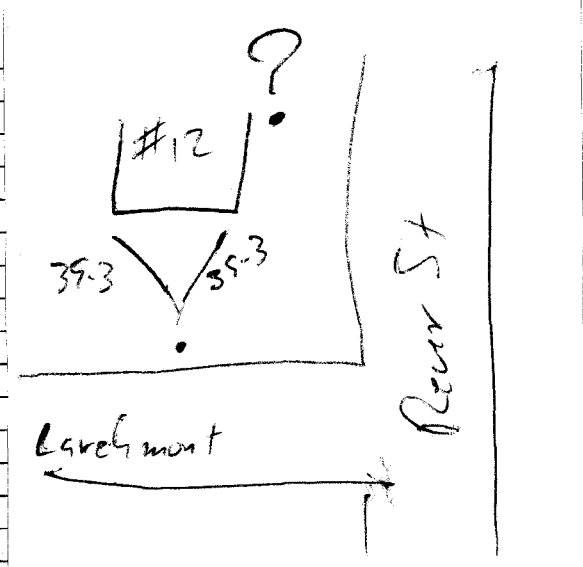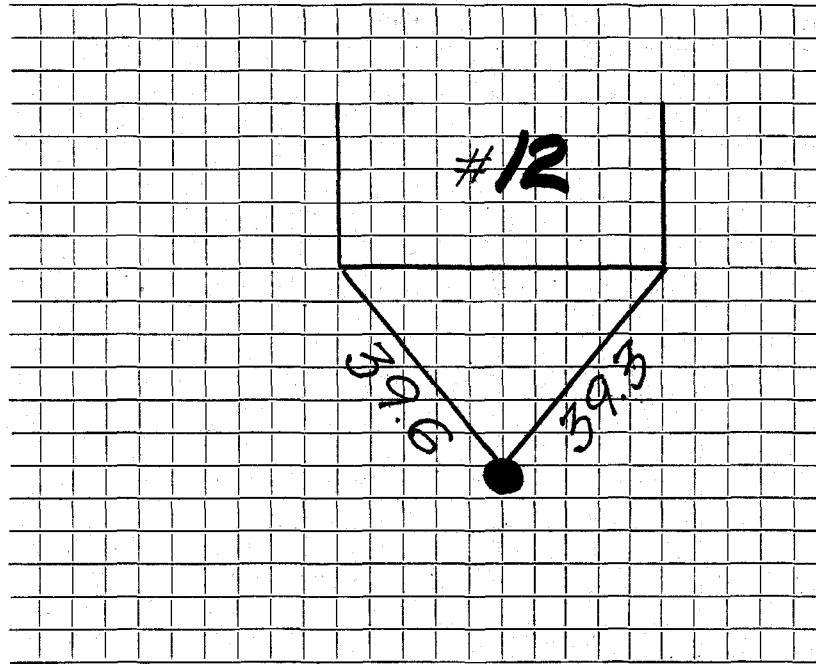

Connection made in ..... Street. Work completed .....

Remarks: .....

.....

.....