

## WATER SERVICE RECORD

Name **William Ribich**

Service No.

Address **18 Revere Street**

Location


Repair ~~Renewal New Service~~ **Kirkland & Shaw #4105**

Date		Material	Amount	Total	Date		Amount	
12/12/84	65'	1" Copper						
	2	1" 3 Part Unions						
						NON CHARGE		
					11-6-57	Labor	2	04
					30' - 1"	Copper tubing @ .5202	15	61
					2-1"	Adapters @ 3.10	6	20
							23	85
						(Service broken by contractor)		

TOWN OF LEXINGTON — BOARD OF PUBLIC WORKS

WATER DIVISION

Sketch of Service Here

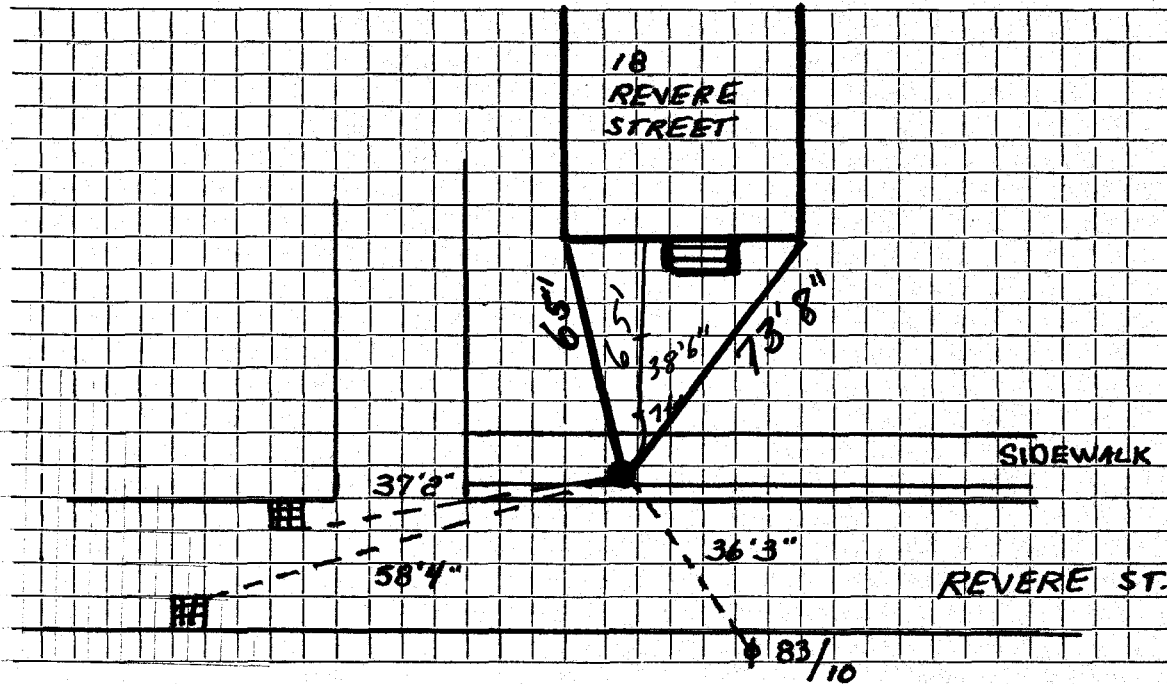

Connection made in \_\_\_\_\_ Street. Work completed \_\_\_\_\_

Remarks: 7' FROM CURB 1" 3 PART UNION INSIDE

38' FROM CURB 1" 3 PART UNION INSIDE