

WATER SERVICE RECORD

Name **Louis Tropeano**

Service No.

18

Address **20 Bayona Street**

Location **Lexington**

~~Henry Beckwith~~ - New Service

COM. 2-16-53


Date	Material	Amount	Total	Date	Amount
1/30/53	Labor	7 58		1-23-53	Deposited 75 00
	10% overhead	76	8 34	2-16-53	Refunded (07
	68' -3/4" copper tubing@.34	23 12			<u>NON CHARGE</u> 74 93
	1 -3/4" C x 1/2 I.W.H. stop & waste	4 00	1/30/53	Labor	13 00
	1 -3/4" C x 3/4" C. union	1 72		19' -3/4" copper tubing@.34	6 46
	3 hrs. Littlefield shovel	21 00		1 -3/4" C. corp-cock	4 33
	1 hr. trucking	75		1 - 3/4" C x 3/4" C. curb-cock	4 67
	patching 16 x 3	16 00		1 box and rod	3 90
			74 93	1 -1/2 offset tail piece	50
				1 -1/2 streight tail piece	50
				2 hrs. Littlefield shovel	14 00
				1 hr. trucking	75
					<u>48 11</u>

DATE _____

TOWN OF LEXINGTON — BOARD OF PUBLIC WORKS

WATER DIVISION

Sketch of Service Here

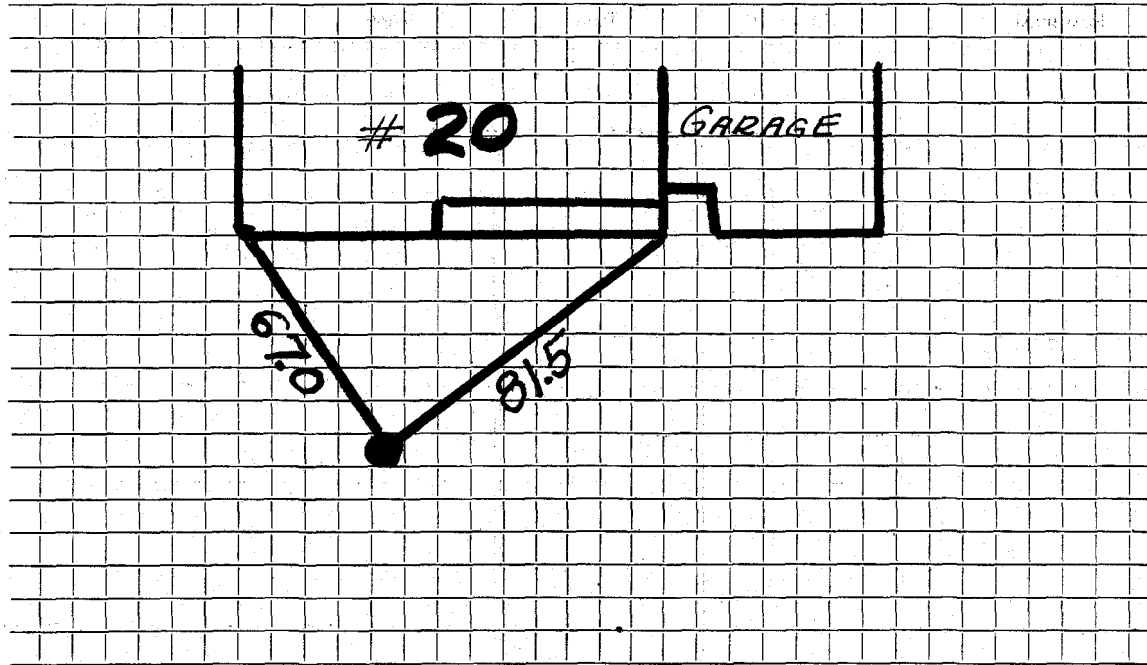

Connection made in Street. Work completed

Remarks:

.....

.....