


DATE 5/7/2020

TOWN OF LEXINGTON — BOARD OF PUBLIC WORKS

WATER DIVISION

Sketch of Service Here

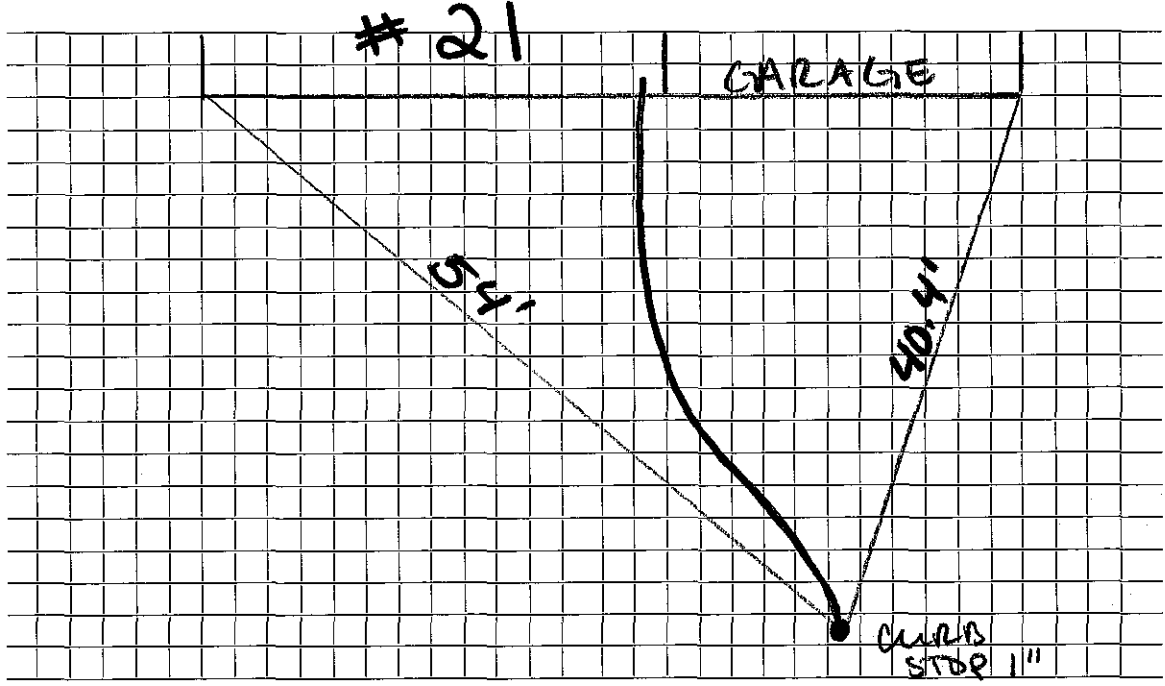

Connection made in Reverse Street. Work completed

Remarks:

.....

.....