

WATER SERVICE RECORD

Service No. 330 (1956)

Name Mrs. Rose Allia

3190

Address 22 Revere Street

Location


~~Repair—Renewal—New Service~~*Comm. 2-25-57*

Date	Material	Amount	Total	Date	Amount
11/3/56	Labor	52 10		10-29-56	Deposit \$ 100 00
	10% overhead	5 21	57 41	3-6-58	<i>Paid</i> 9 00
	60' - 3/4" Copper Tubing @ .4396	26 38			NON CHARGE \$ 109 00
	1 - 3/4" Cx $\frac{1}{2}$ I.W.H. Stop & Waste	4 96		11/3/56	Labor 58 95
	1 hr. Trucking		75	25' - 3/4" Copper tubing @ .4396	10 99
	3 hrs. Town Shovel @ 6.50		19 50	1 - 3/4" C. Corp Cock	4 64
			109 00	1 - 3/4" C. Curb Cock	5 94
				1 Box & Rod	4 62
				1 - $\frac{1}{2}$ Straight tailpiece	50
				1 - $\frac{1}{2}$ Offset tailpiece	50
				1 hr. Town Shovel	6 50
				1 hr. Trucking	75
				20x3 Patch	20 00
					113 39
					<i>Bill sent 2-27-57</i>

TOWN OF LEXINGTON — BOARD OF PUBLIC WORKS

WATER DIVISION

Sketch of Service Here

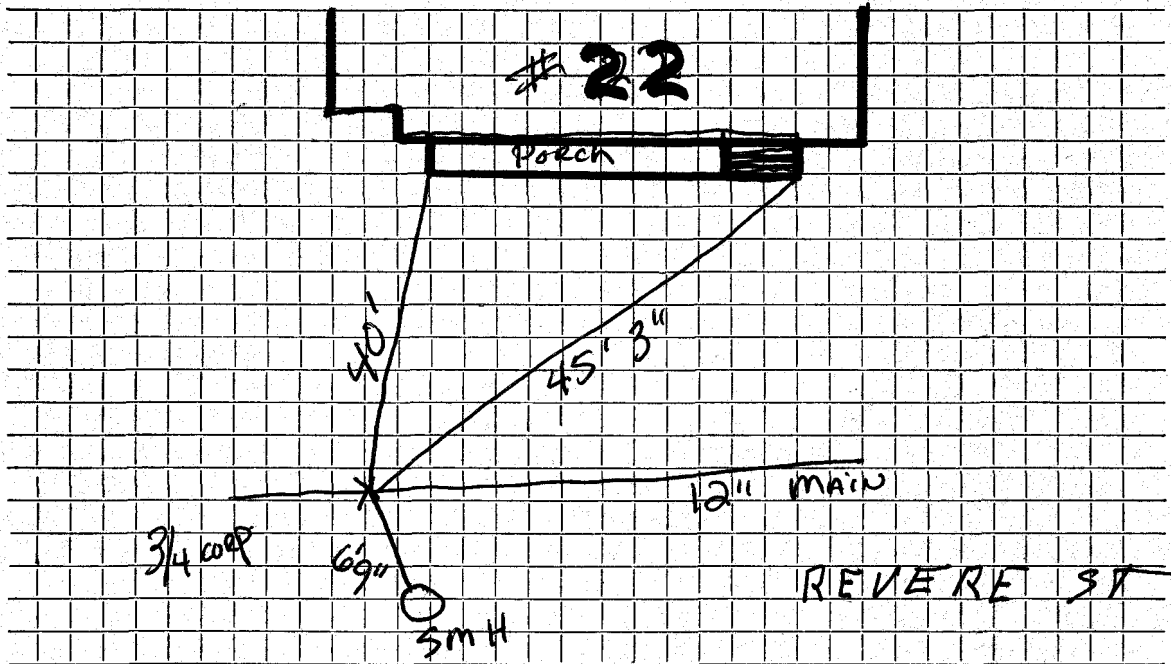

Connection made in Street. Work completed

Remarks:
10.16.92 SERVICE TAPPED ONTO 12" WATER MAIN
DUE TO WATER BREAK

WATER SERVICE RECORD

Name

Service No.

Address

Location 22 REVERE ST REAR


Repair—Renewal—New Service mclaughlin

Date	Material	Amount	Total	Date	Amount
7/29/99	OUT				IN
9 1/2'	1.5 COPPER				1.5 COPPER
	12 X 1.5 SADDLE				UNIONS
	1.5 COP				
	1.5 CURB				
	BUFF 10 BOX				

DATE _____

TOWN OF LEXINGTON — BOARD OF PUBLIC WORKS

WATER DIVISION

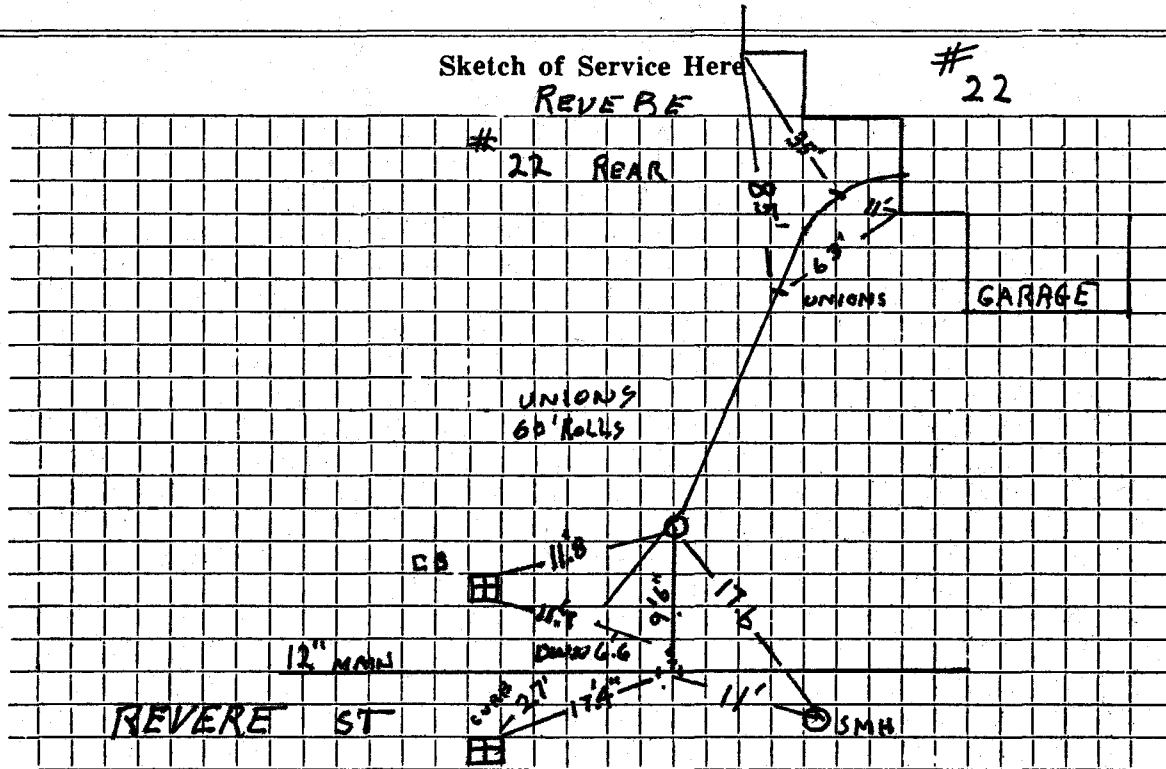

Connection made in Revere St, Street. Work completed

Remarks:

.....

.....