

WATER SERVICE RECORD

Name Stewart E. Waef

Service No. 338

Address 23 Revere St.

Location Lexington

Repair—Renewal—New Service ~~XXXXXX~~ Com. 12-29-52


Date	Material	Amount	Total	Date	Amount
12/22/52	Labor	1 63		12-16-52	Deposited 100 00
	10% overhead	16	1 79	12-29-52	Refunded 83 26
	30'-3/4" Copper Tubing @.34		10 20		NON-CHARGE 16 74
	1-3/4" Cx 1/2" I.W.H. Stop & Waste		1 00	12/22/52	Labor 9 97
	1 Hr. Trucking		75	10'-3/4" Copper tubing @.34	3 40
			16 74	1-3/4" C. Adapter	1 95
	TRENCH DUG BY OWNER			1-3/4" Cx 3/4" C. Curb-cock	4 67
				1-Box & Rod	3 90
				1-1/2 Straight Tail Piece	50
				1-1/2 offset Tail Piece	50
				1 Hr Trucking	75
				Patchin . 6 x 3	6 00
					31 64

DATE _____

TOWN OF LEXINGTON — BOARD OF PUBLIC WORKS

WATER DIVISION

Sketch of Service Here

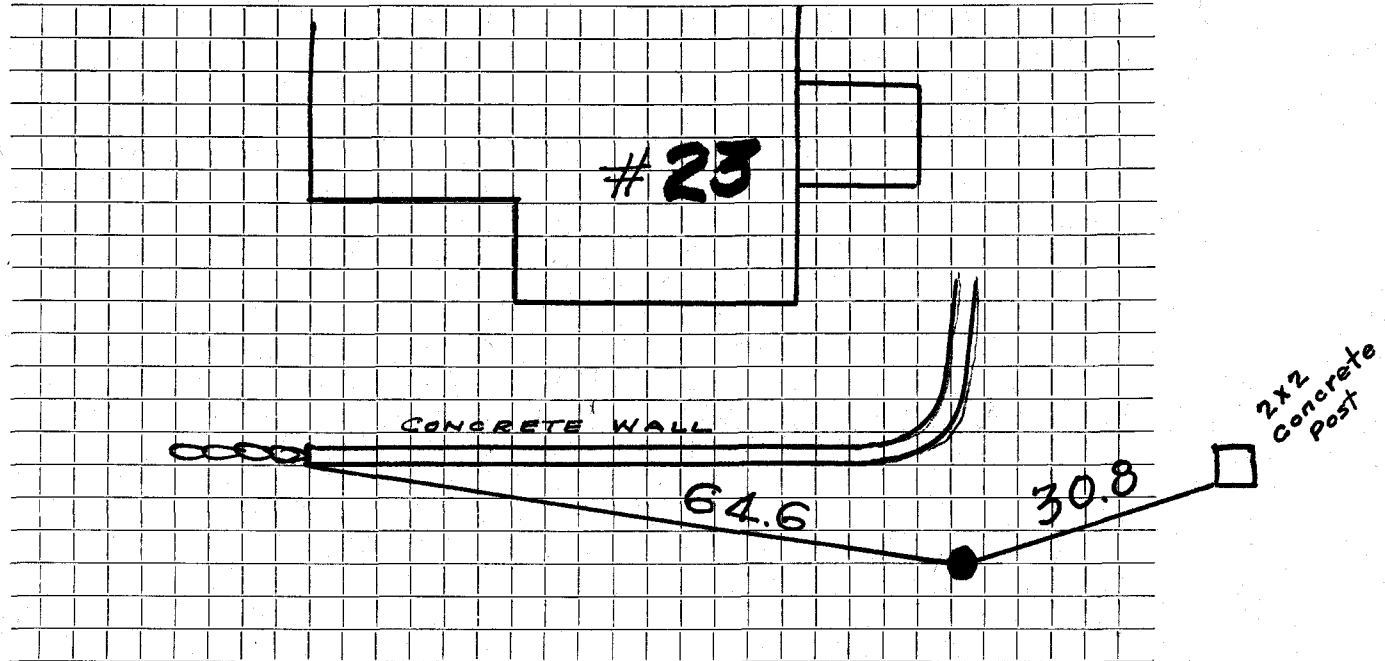

Connection made in Street. Work completed

Remarks: *Original Service 7-17-41*

.....
.....